


Key Plan



North

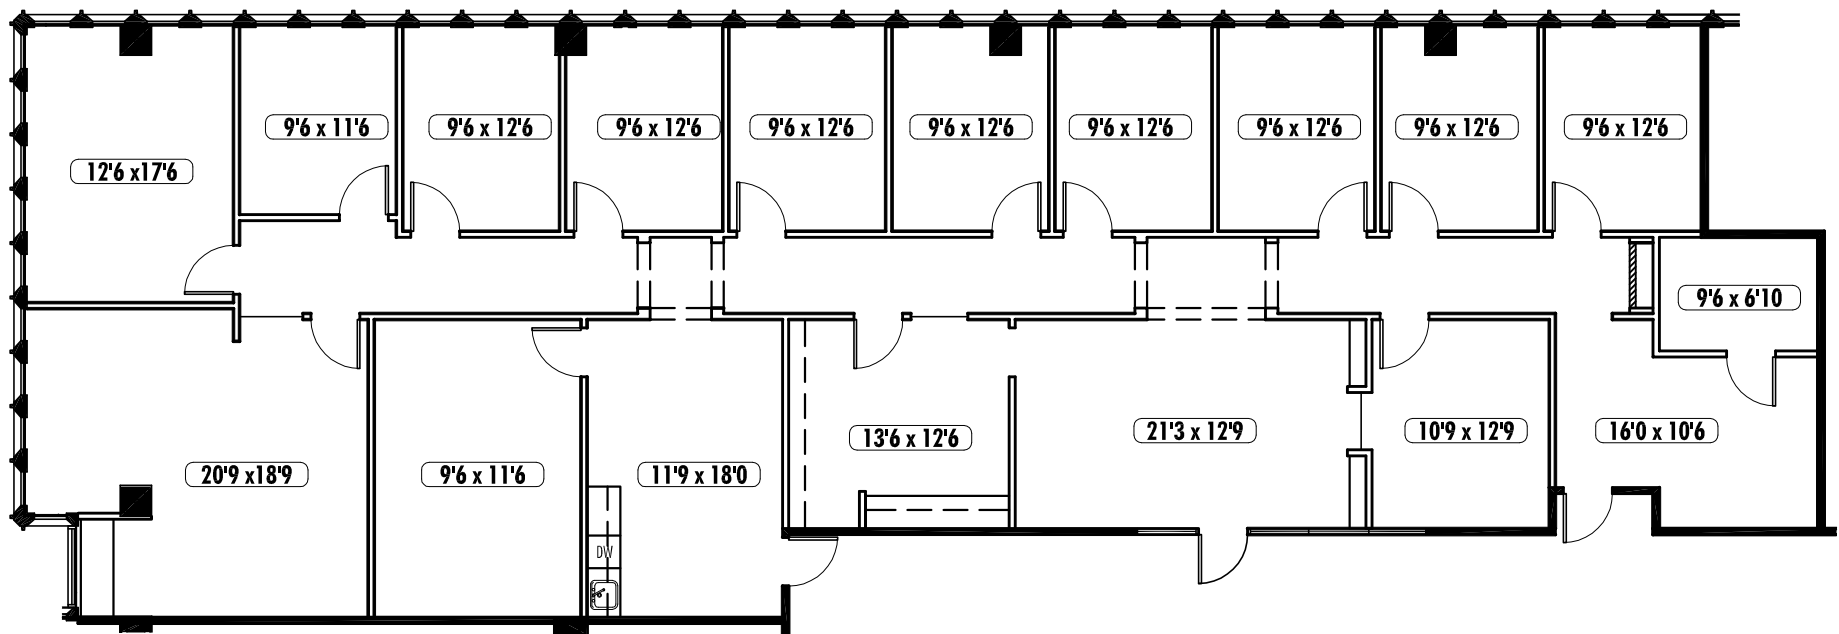

Marquis One • Suite 2550 • 4,249 RSF

As Built