


Key Plan



North

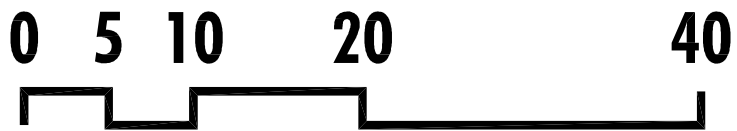

This suite has not been field  
verified by Veenendaal Cave, Inc.



**Marquis Two • Suite 1275 • 4,491 RSF**

**As Built**