


Key Plan



North

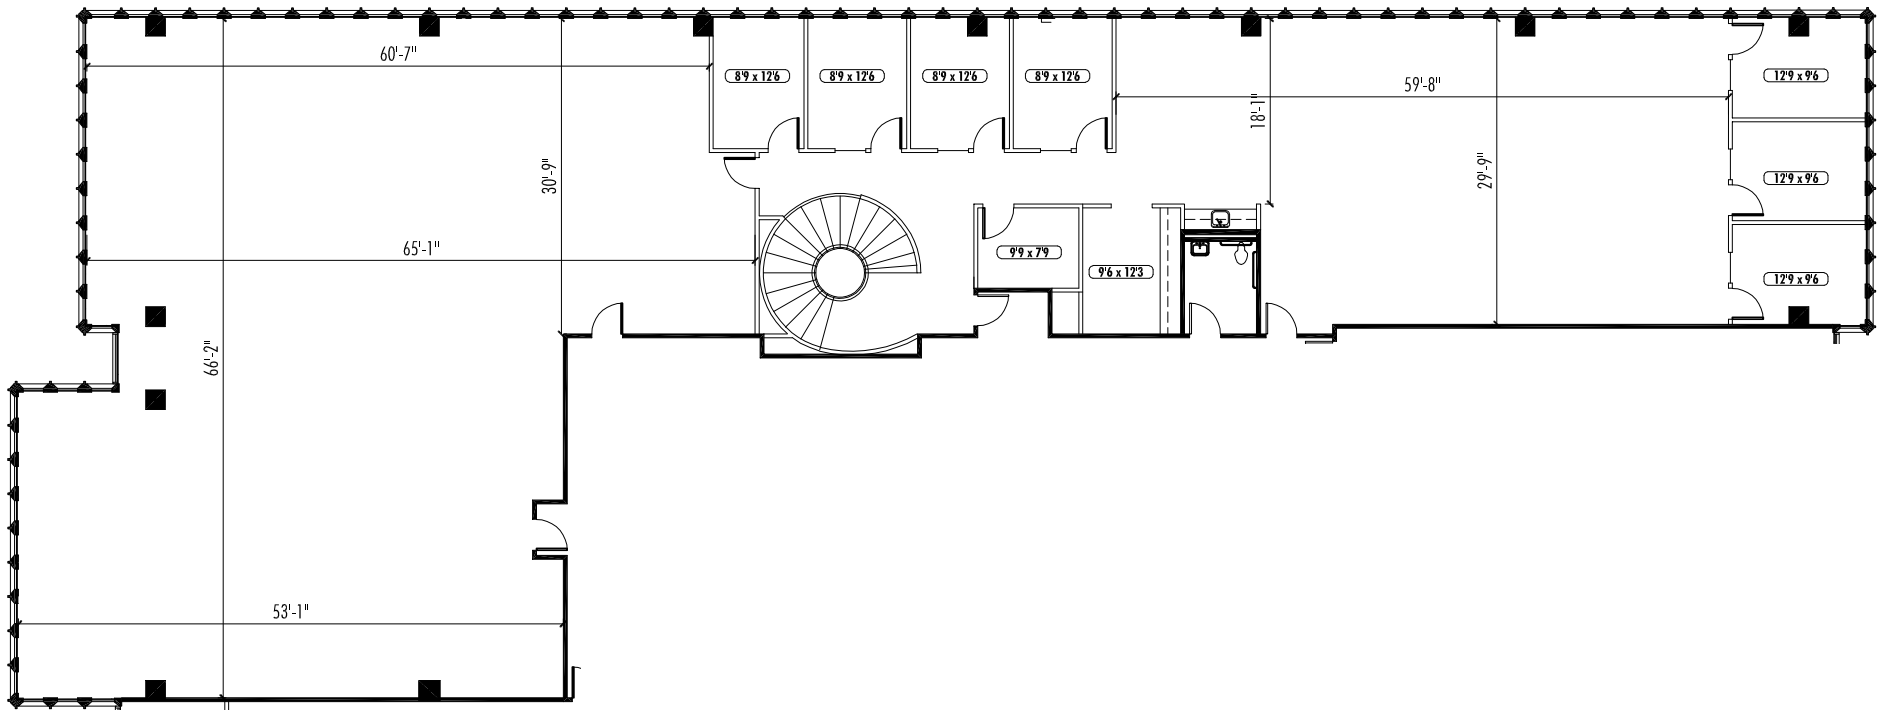

NELSON Marquis One • Suite 2001 • 8,454 RSF

As Built