


Key Plan



North

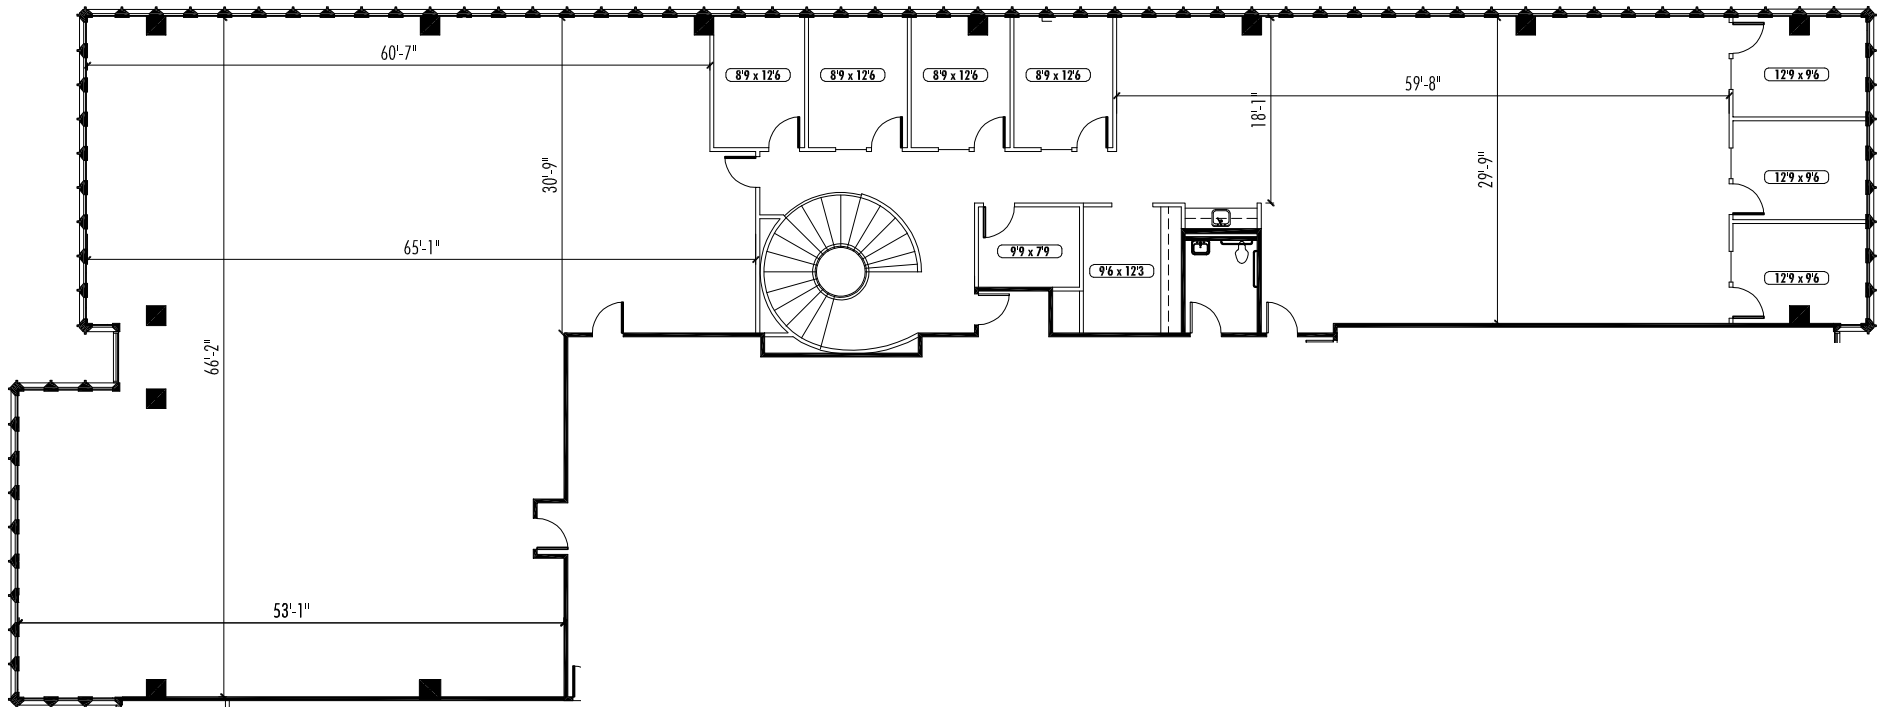

NELSON Marquis One • Suite 2010 • 8,793 RSF

As Built