


Key Plan

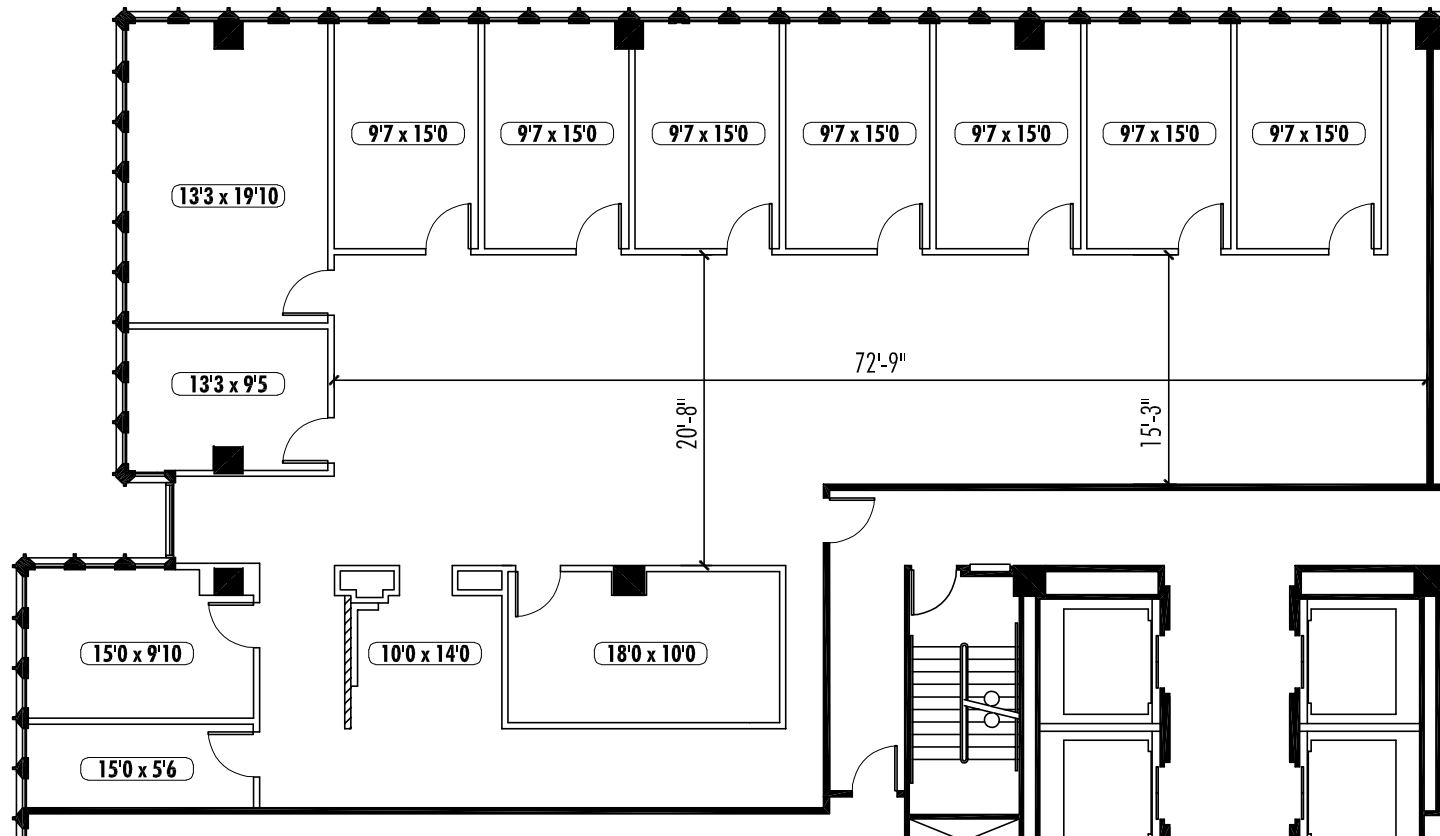

NELSON Marquis One • Suite 2350 • 4,598 RSF

As Built