


Key Plan



North

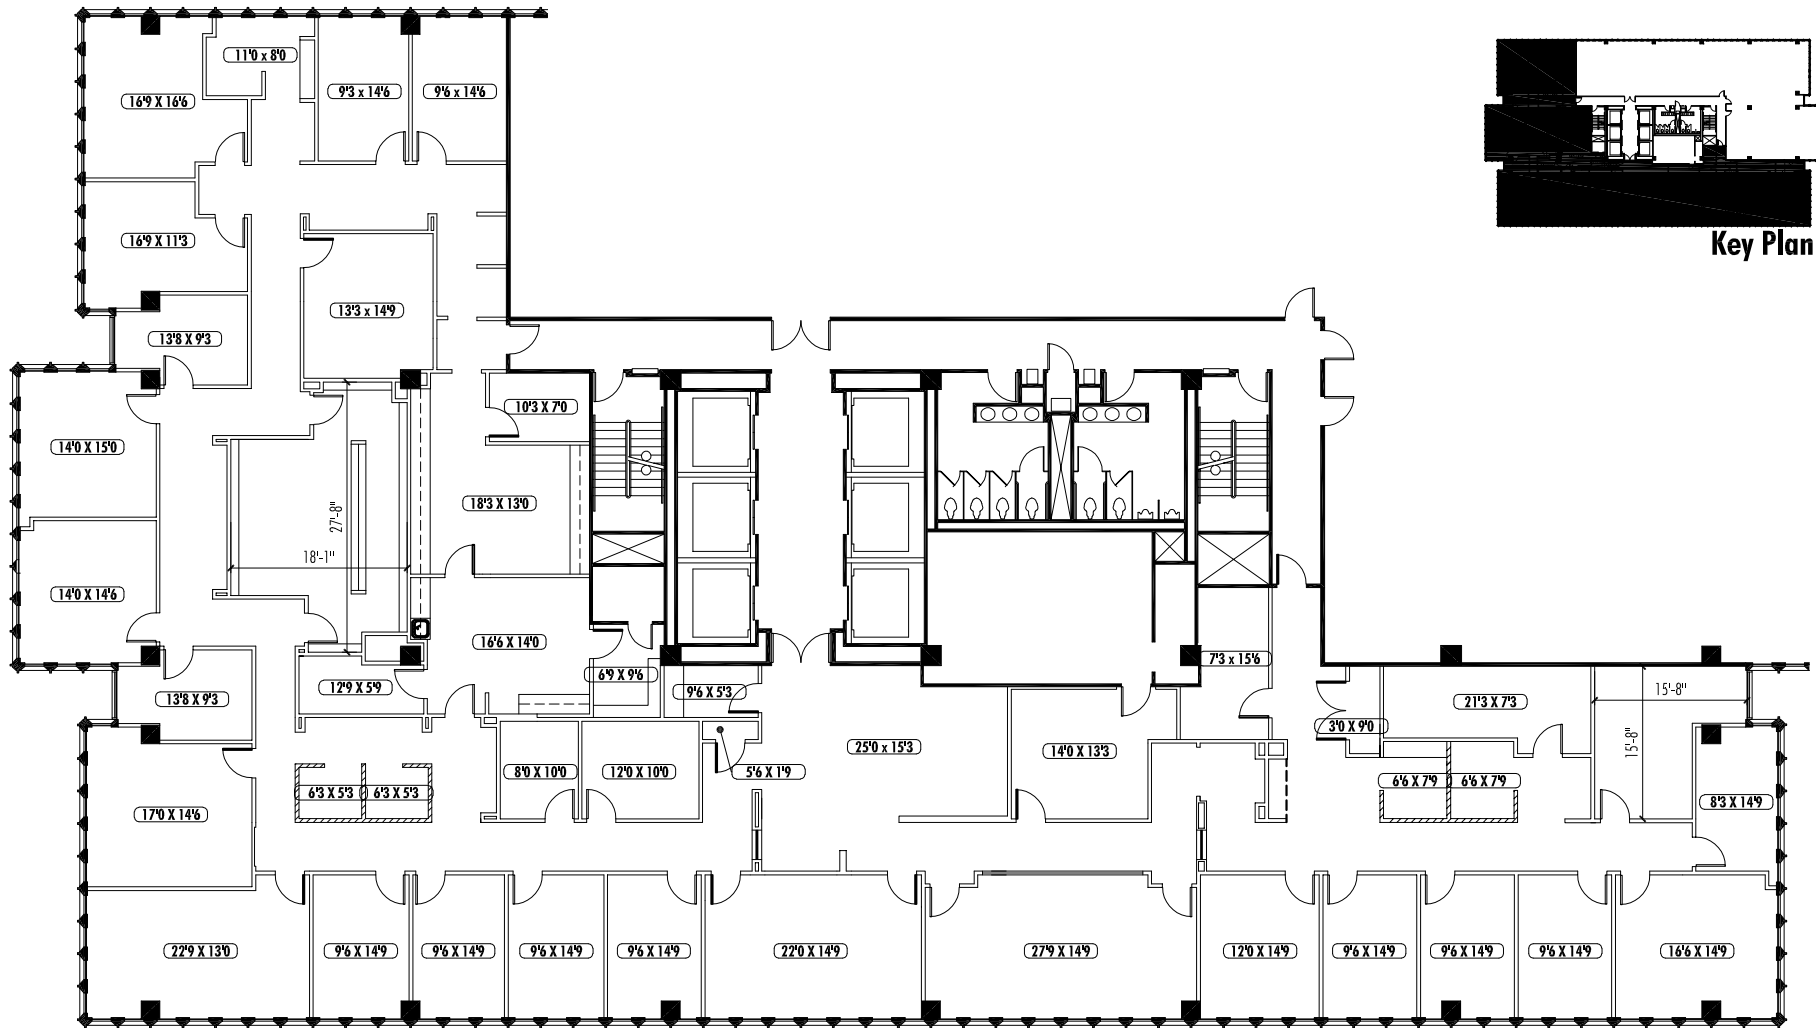

**NELSON** Marquis One • Suite 2800 • 11,822 RSF

**As Built**