


Key Plan



North

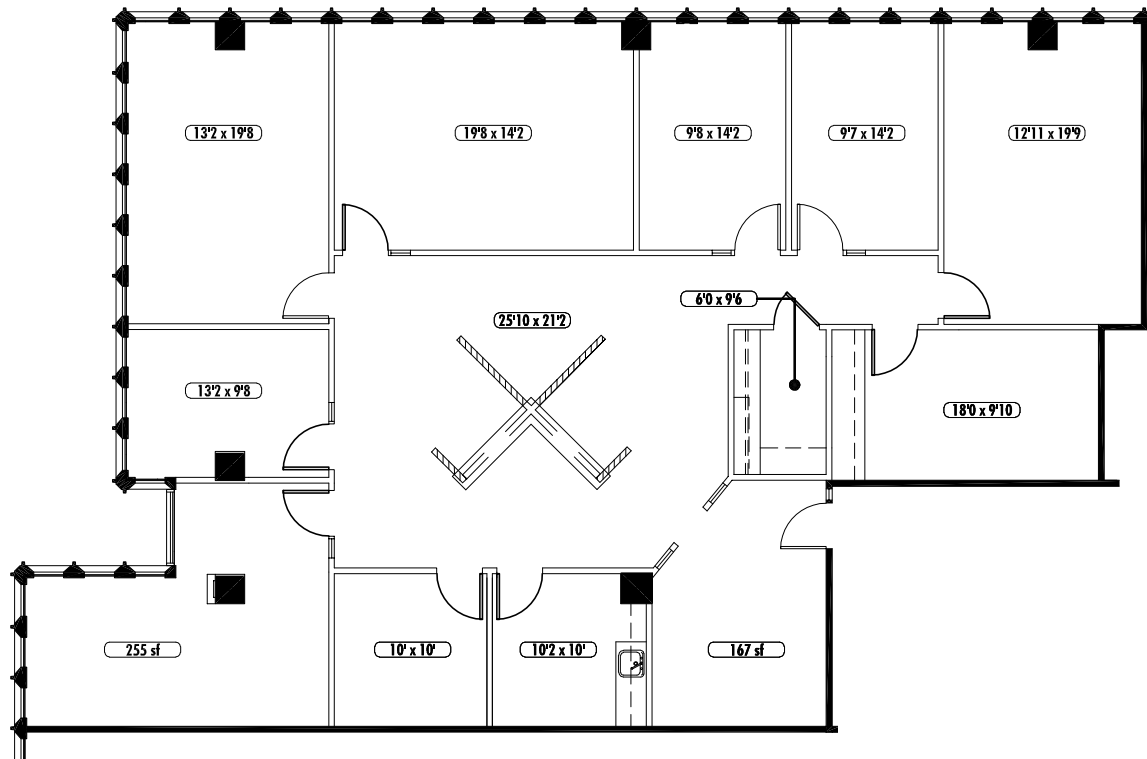

NELSON Marquis One • Suite 505 • 3,460 RSF

As Built