




Key Plan



North

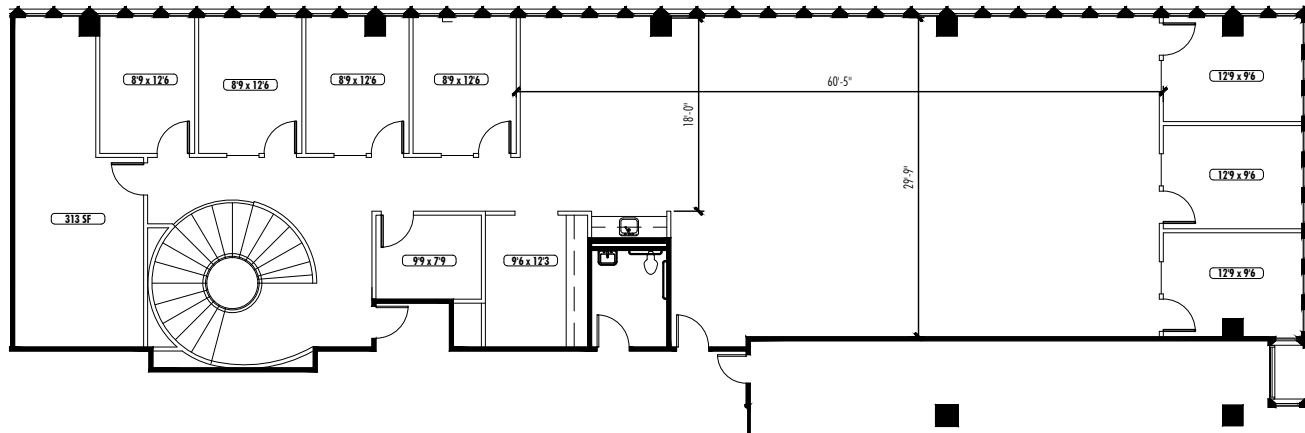

This suite has not been field  
verified by Veenendaal Cave, Inc.



Marquis One • Suite 2001 • 4,320 RSF

As Built