


Key Plan



North

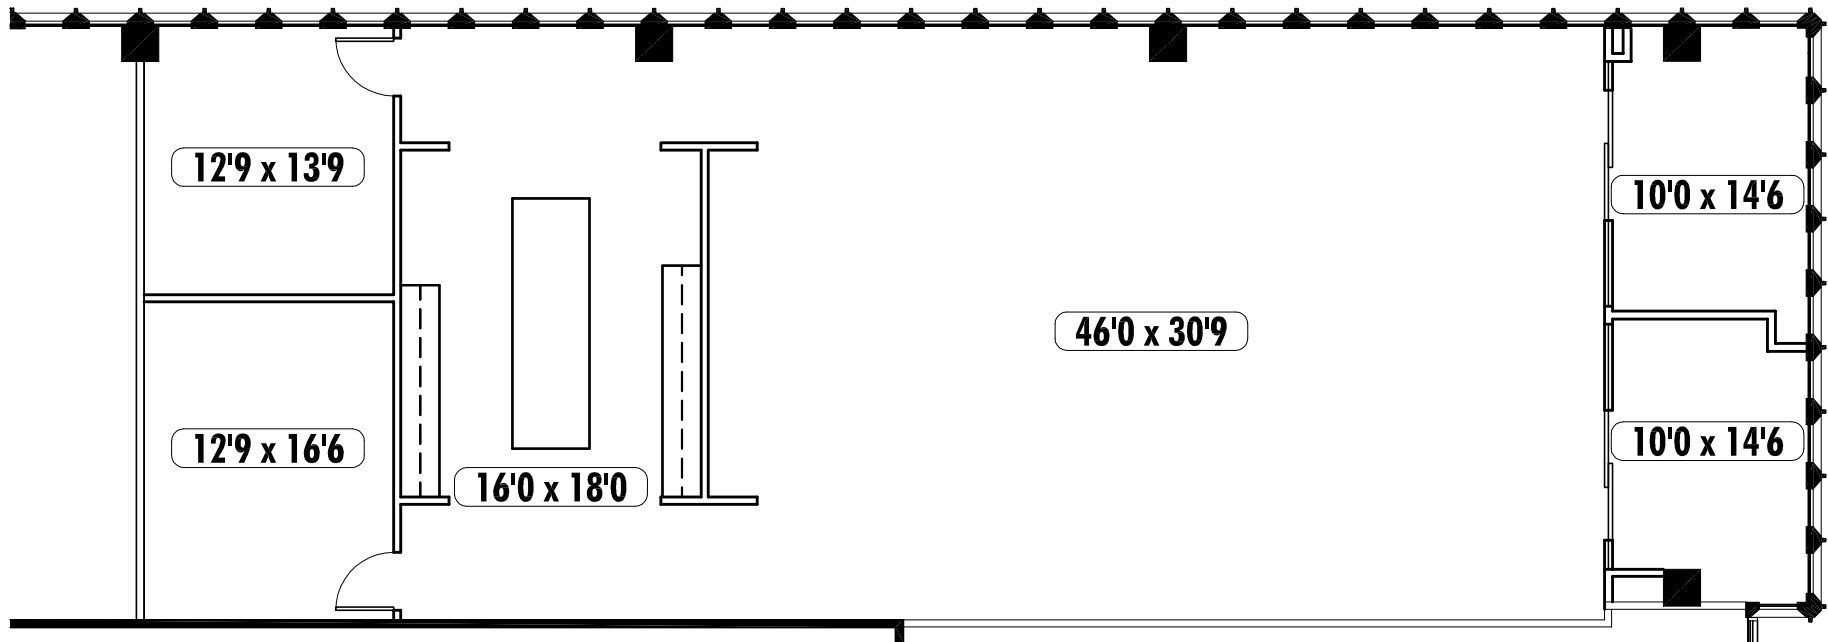

This suite has not been field verified by Veenendaal Cave, Inc.



Marquis One • Suite 2375 • 3,141 RSF

As Built