


Scale: Not To Scale

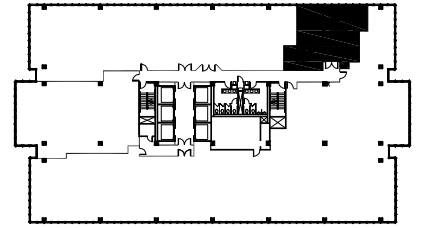

Key Plan



North



This suite has not been field verified by VeenendaalCave, Inc.



MARQUIS
TOWERS



Marquis One • Suite 2460 • 1,168 RSF

As Built