


Key Plan



North 0 5 10 20

This suite has not been field
verified by Veenendaal Cave, Inc.

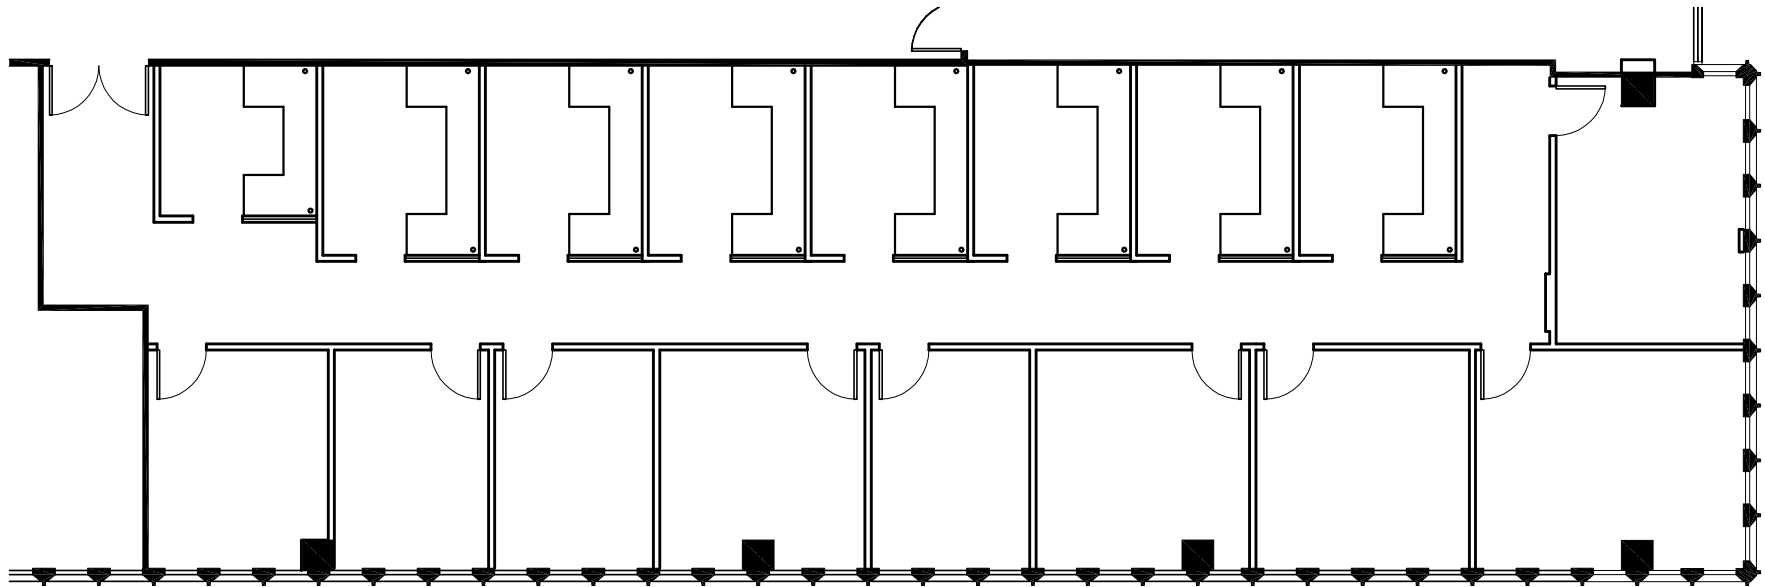

Marquis Two • Suite 2350 • 3,625 RSF

As Built