


North 0 5 10 20 40

This suite has not been field verified by VeenendaalCave, Inc.




Marquis Two • Suite 2500 • 18,201 RSF

As Built

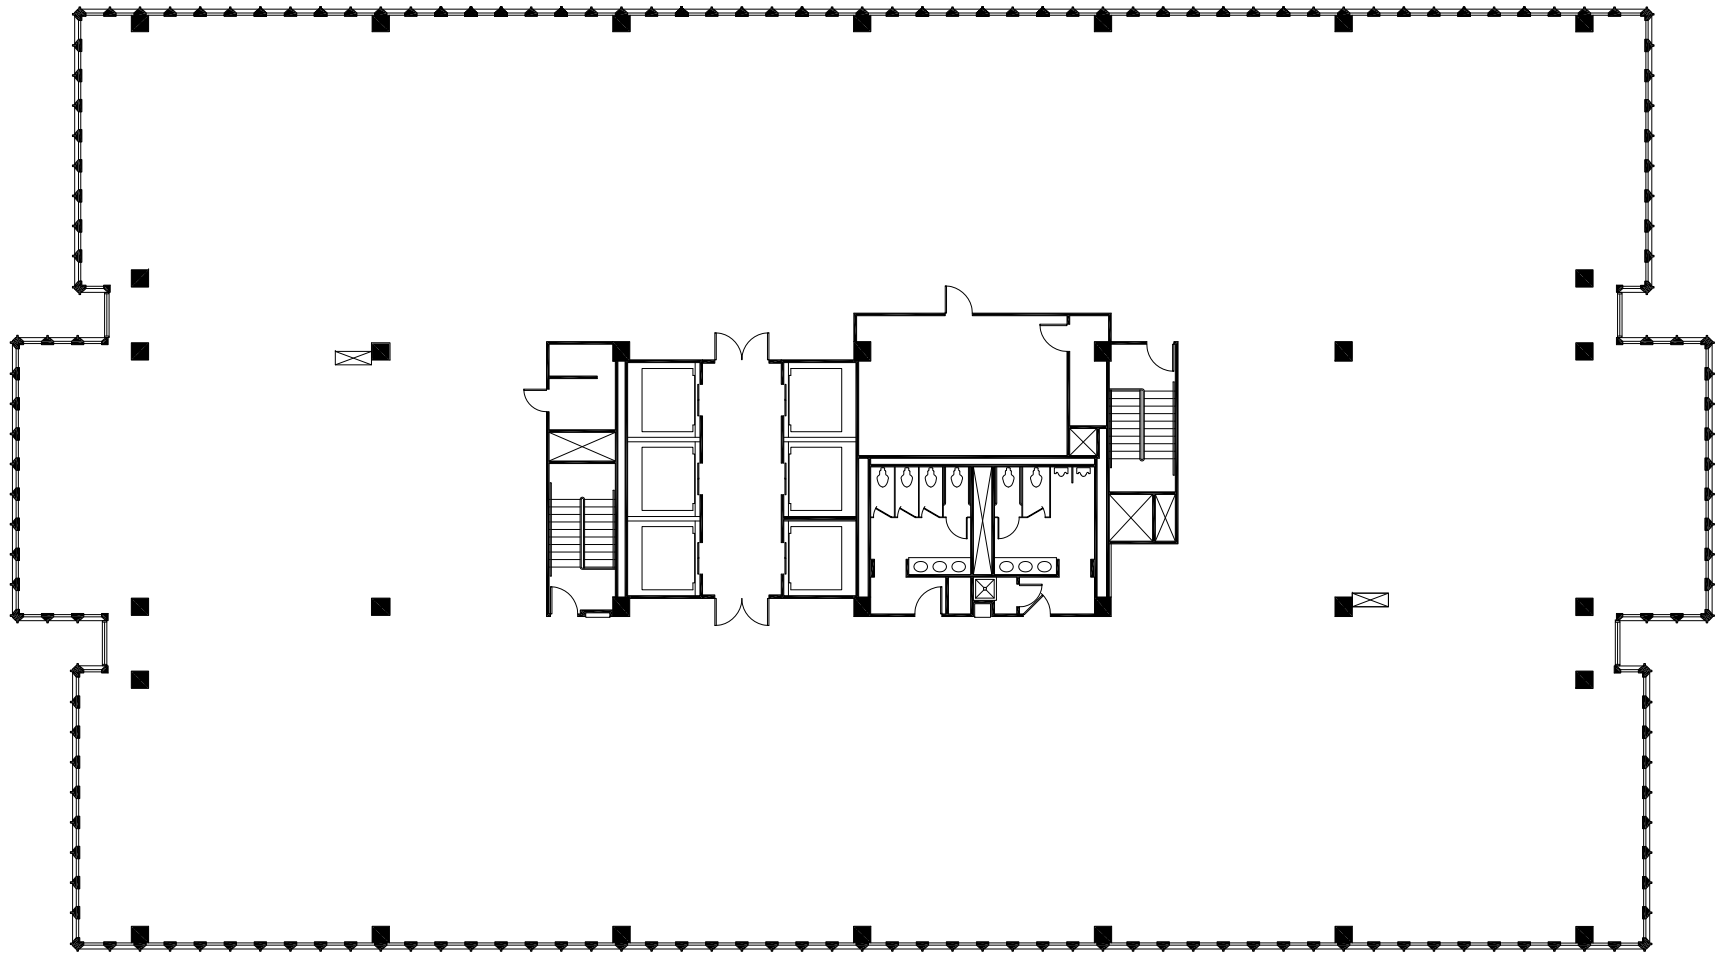

North

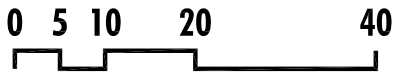


PEACHTREE
CENTER



Marquis Two • 28th floor • 18,201 RSF

As Built

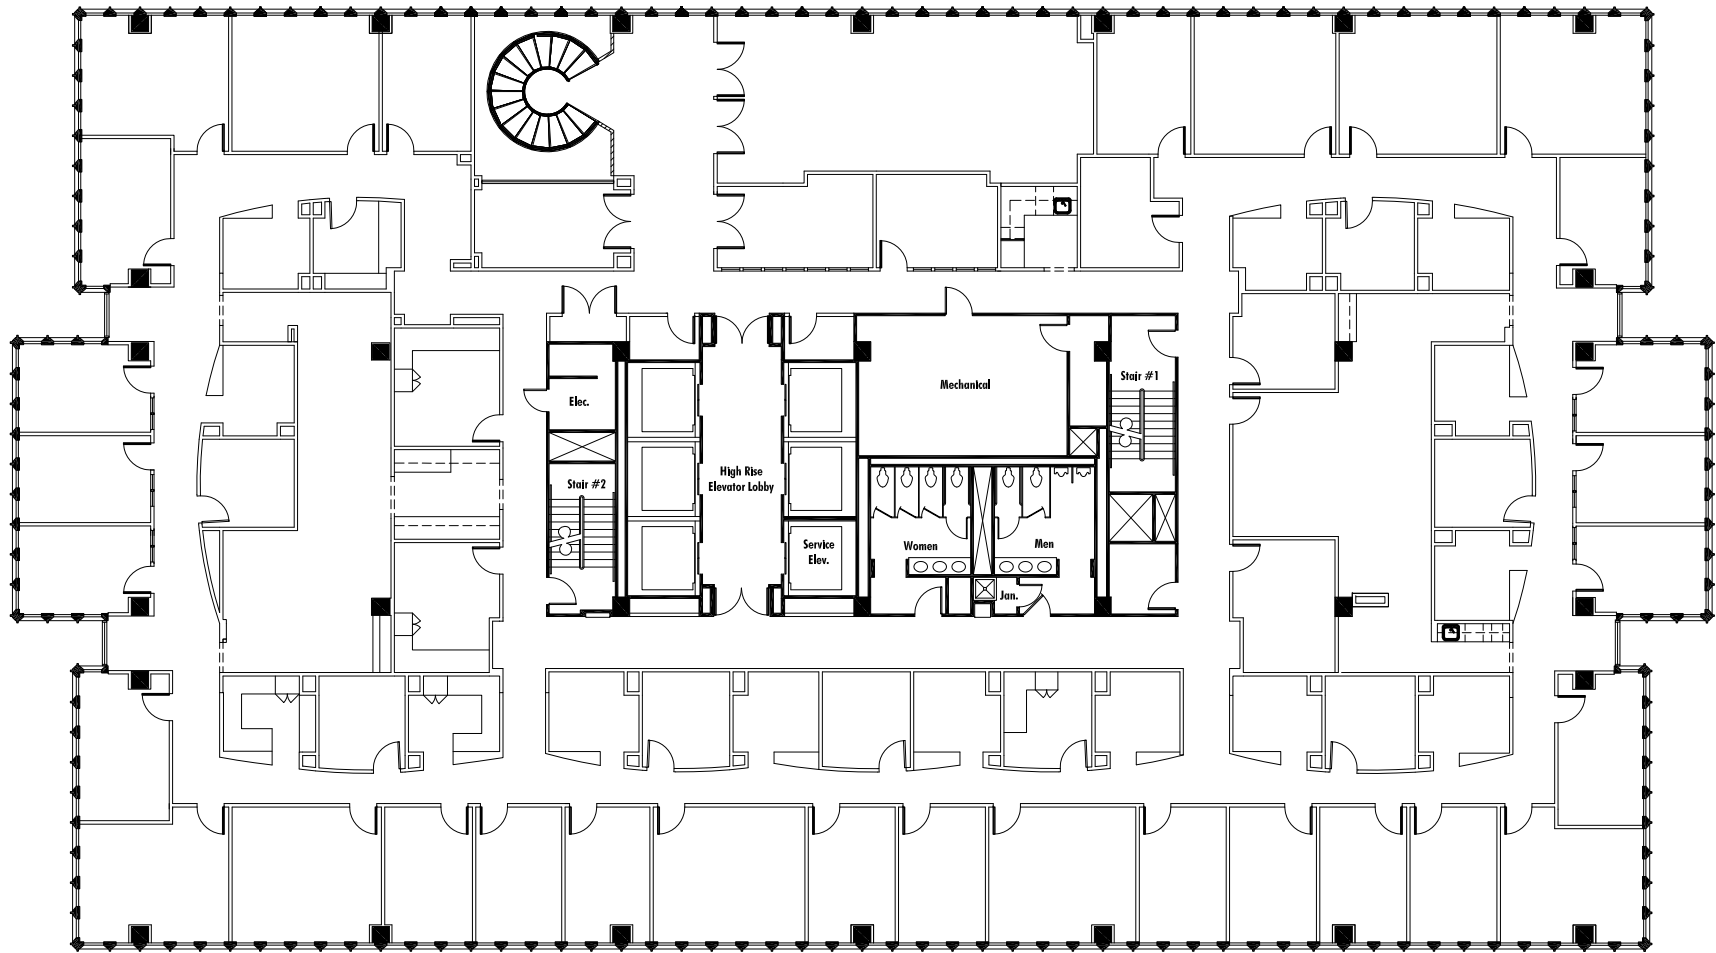

North 0 5 10 20 40


This suite has not been field
verified by VeenendaalCave, Inc.

PEACHTREE
CENTER



Marquis Two • Suite 2700 • 18,201 RSF

As Built

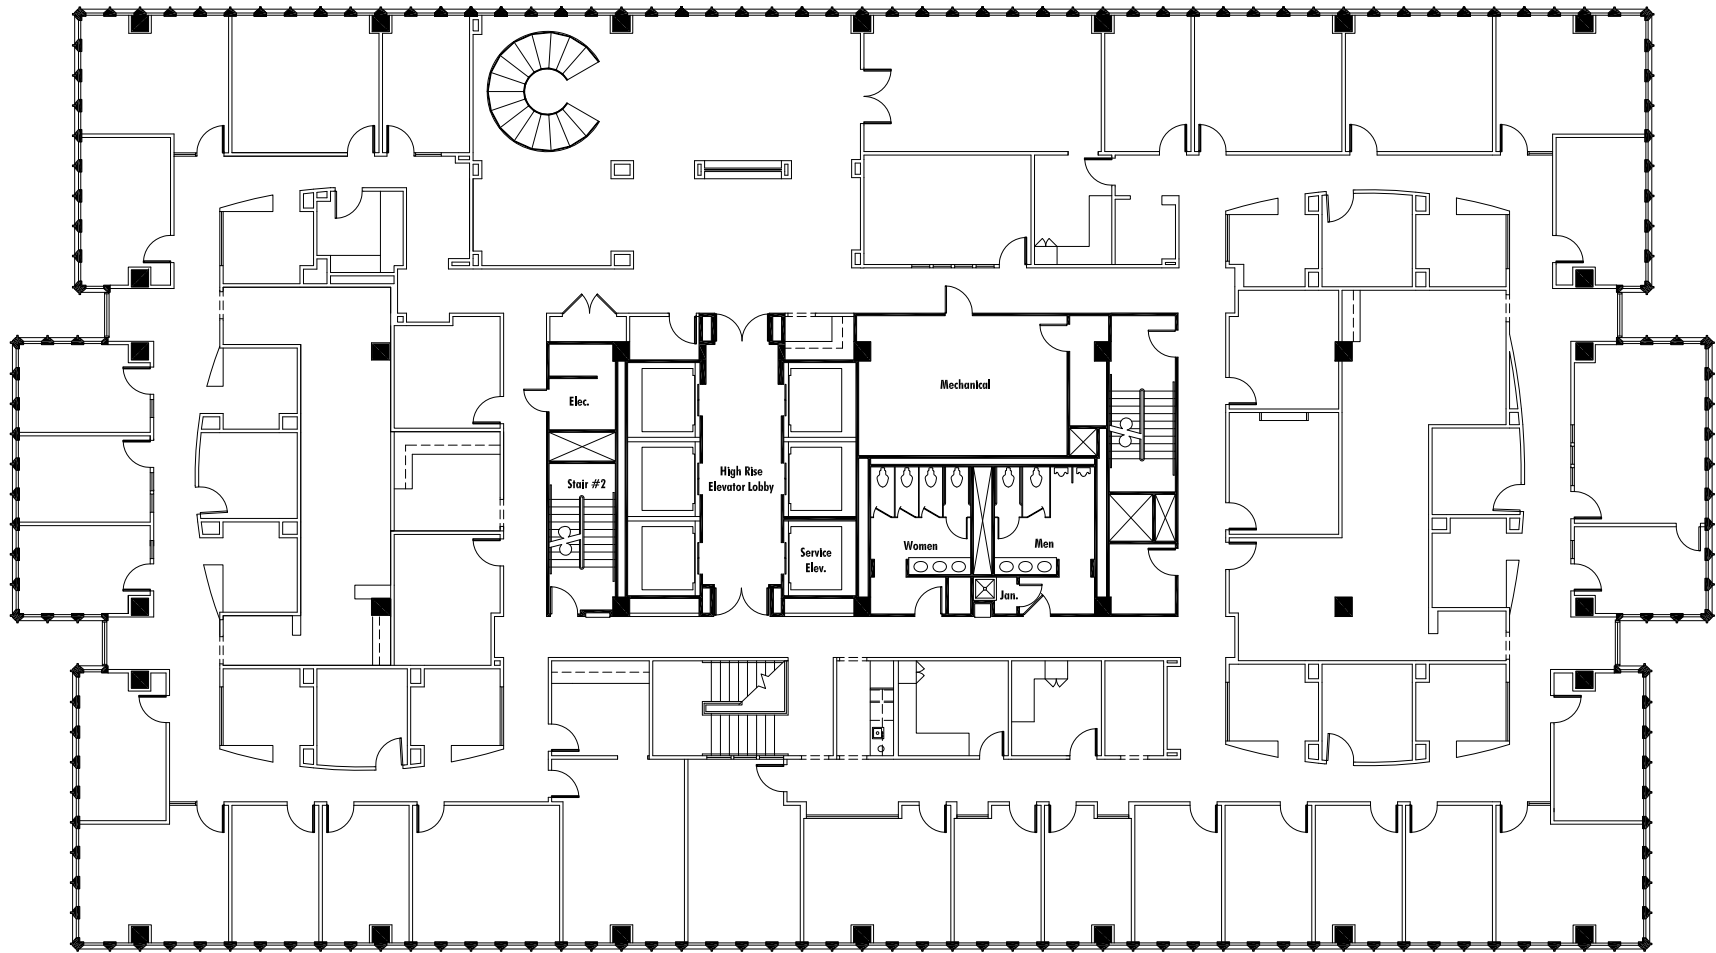

North 0 5 10 20 40

This suite has not been field
verified by VeenendaalCave, Inc.

PEACHTREE
CENTER



Marquis Two • Suite 2600 • 18,201 RSF

As Built