


Key Plan



North

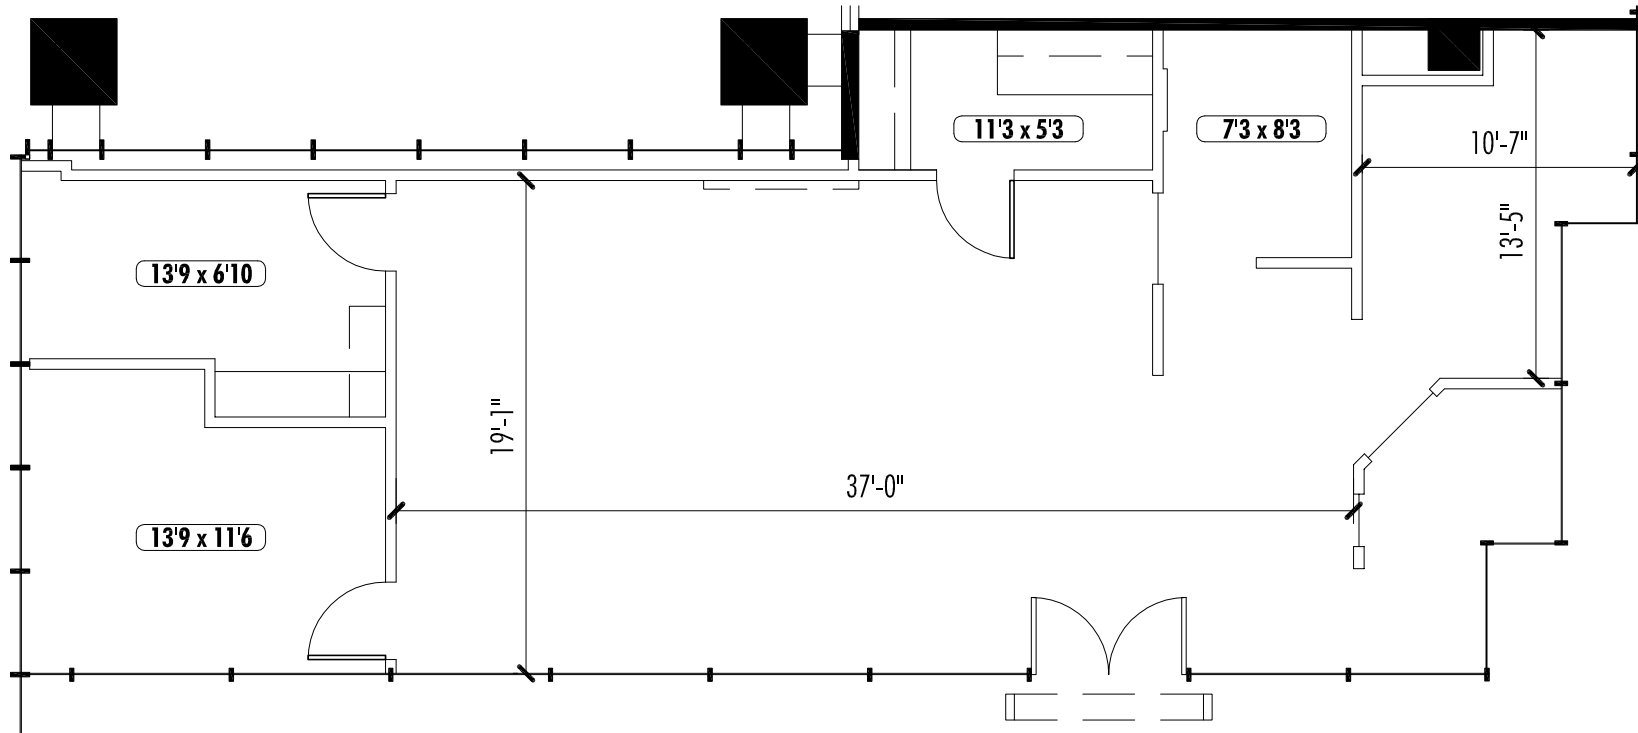

Marquis One • Suite 275 • 1,421 RSF

As Built