


North

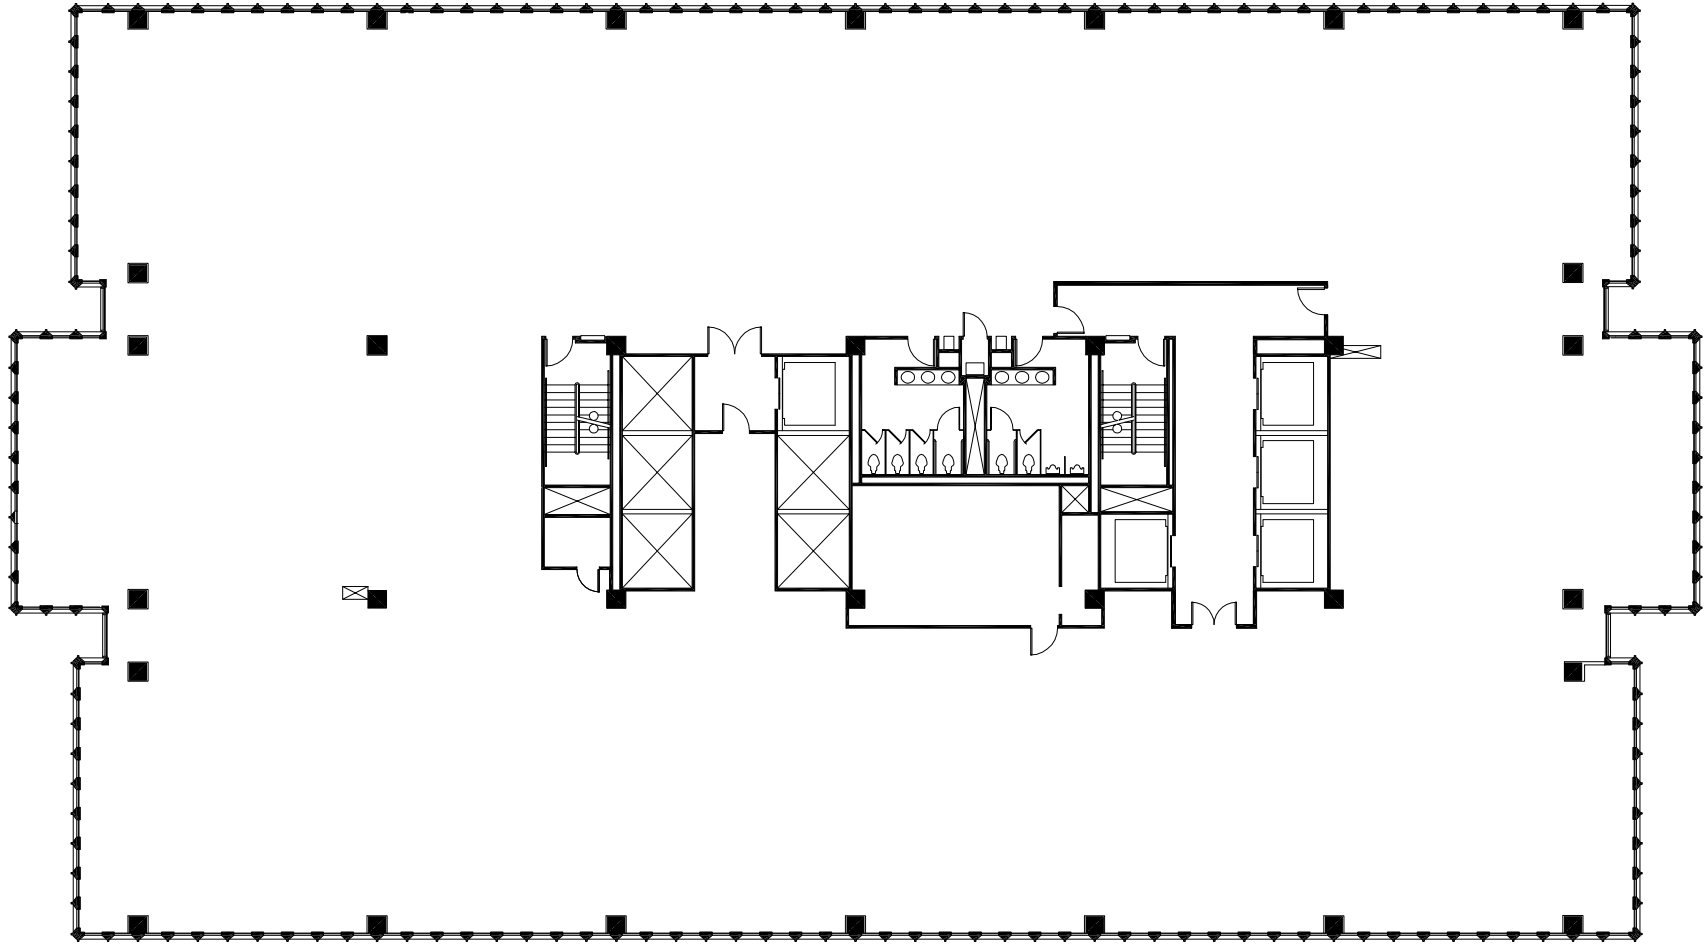

**Marquis One • Suite 400 • 18,101 RSF**

**As Built**




North 0 5 10 20 40

This suite has not been field verified by VeenendaalCave, Inc.



**Marquis One • Suite 700 • 18,101 RSF**

**As Built**

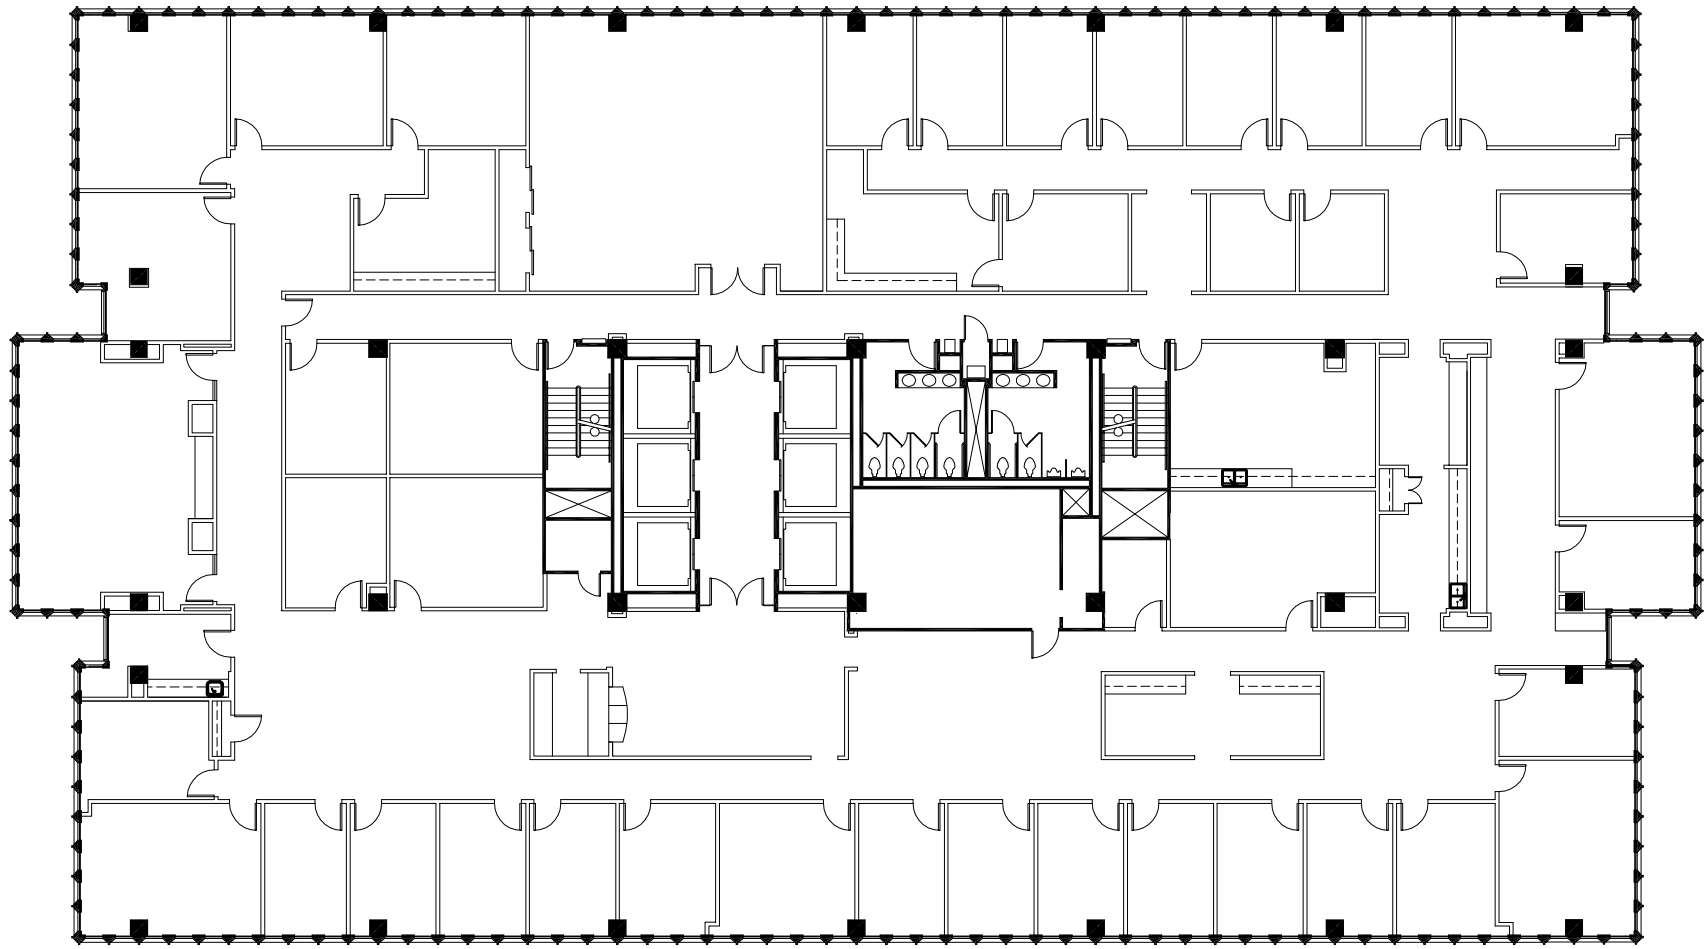

Scale: Not To Scale




North 0 5 10 20 40



**Marquis One • Suite 1800 • 18,413 RSF**

**As Built**

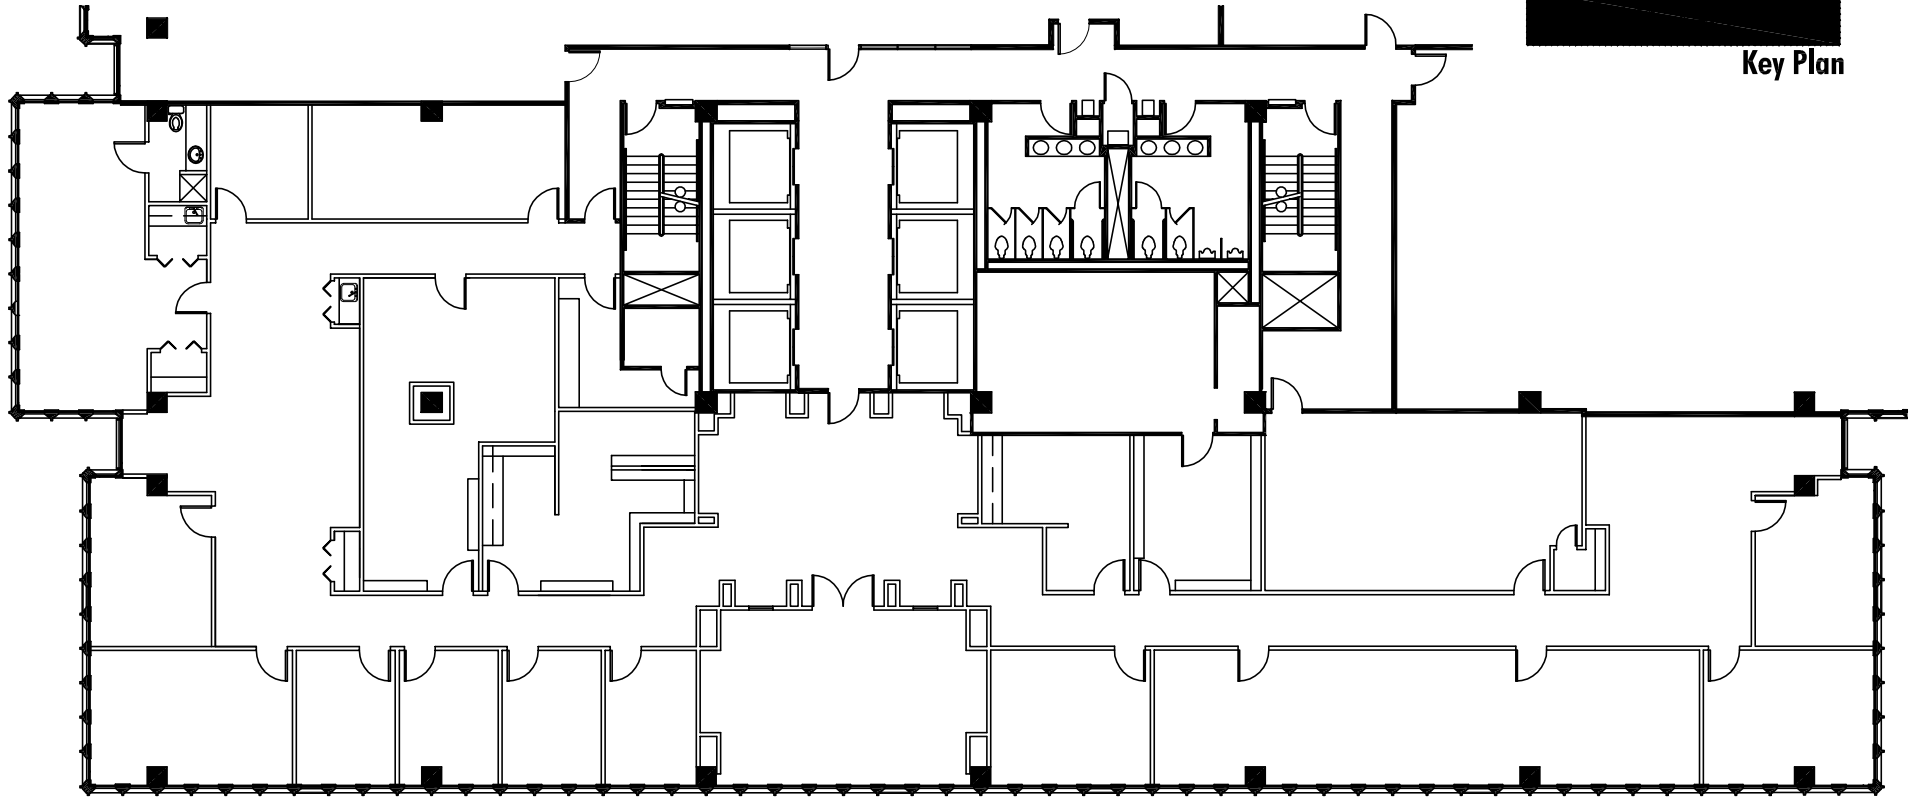

Key Plan




North




**NELSON** Marquis One • Suite 2500 • 9,534 RSF

**As Built**

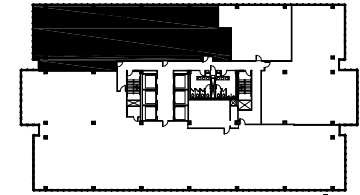

Key Plan


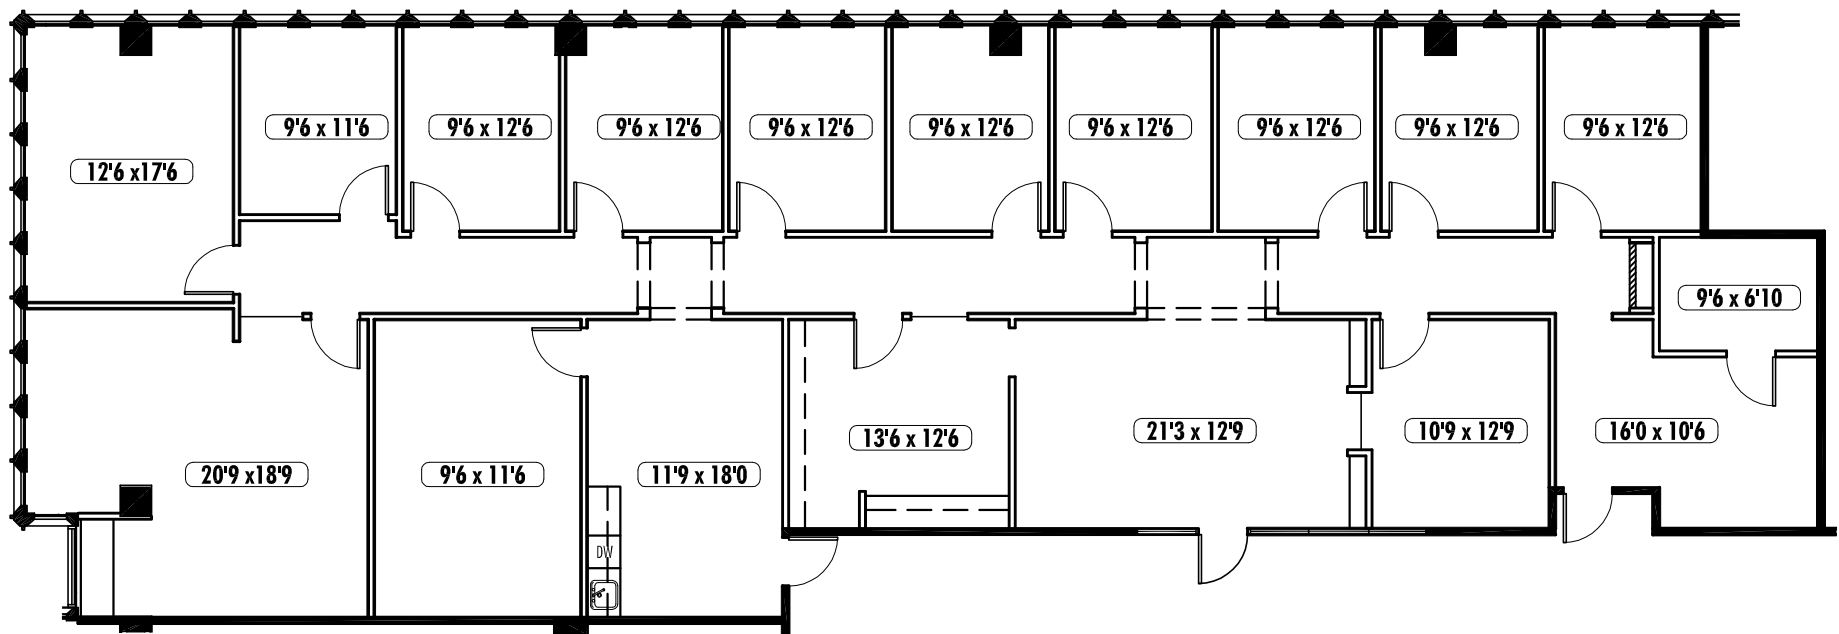


North



**Marquis One • Suite 2550 • 4,249 RSF**

**As Built**

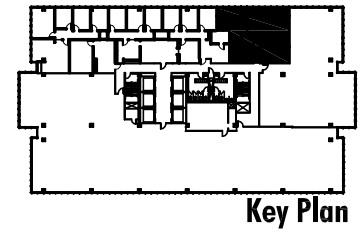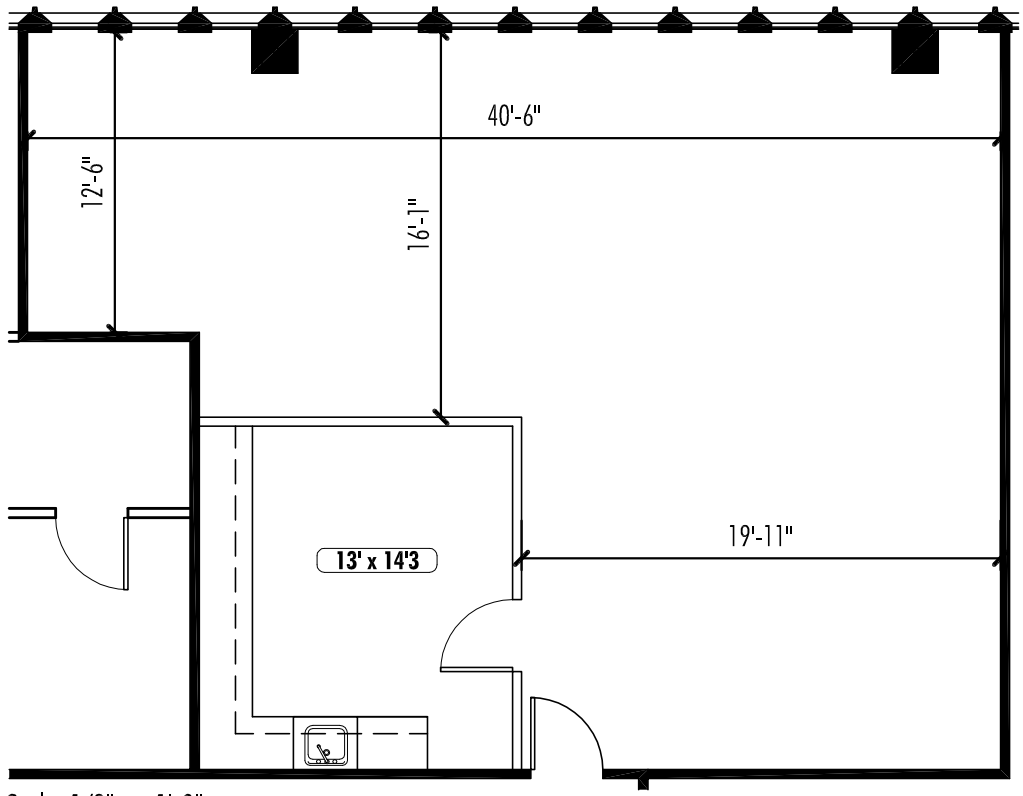


Scale: 1/8" = 1'-0"




**Marquis One • Suite 2560 • 1,357 RSF**

**As Built**

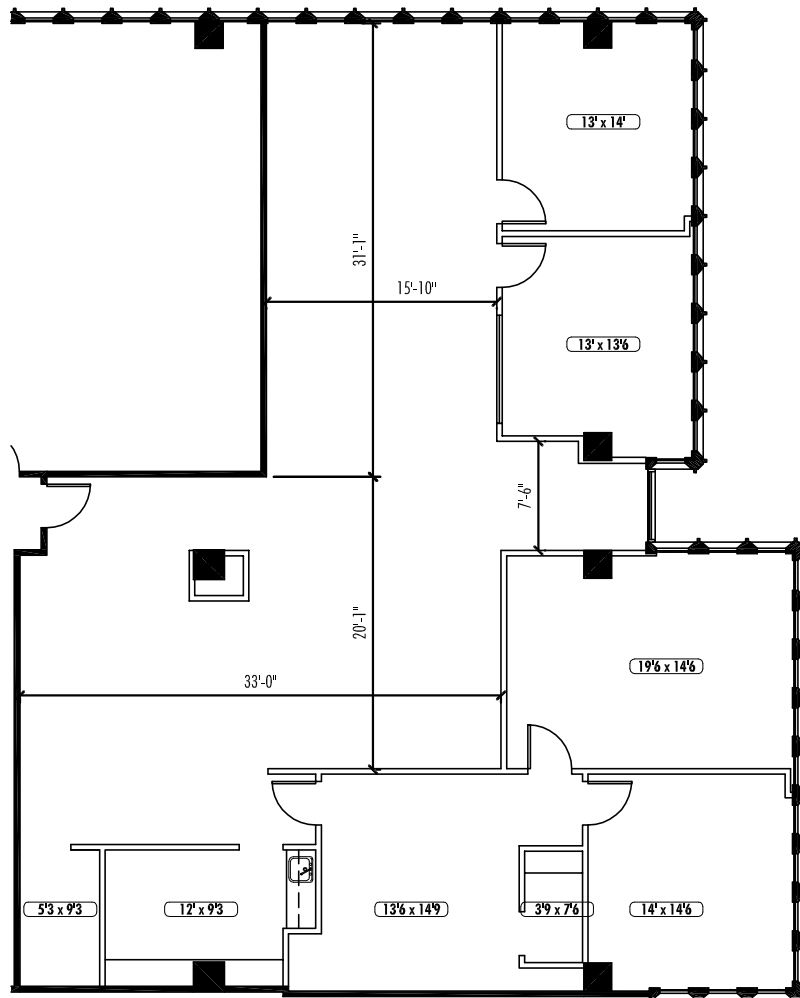


Scale: Not To Scale

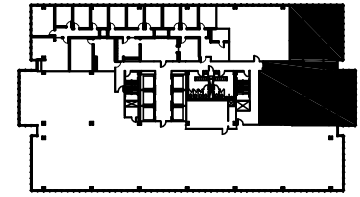

Key Plan



North

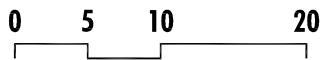


This suite has not been field  
verified by Veenendaal Cave, Inc.



**Marquis One • Suite 2570 • 3,273 RSF**

**As Built**

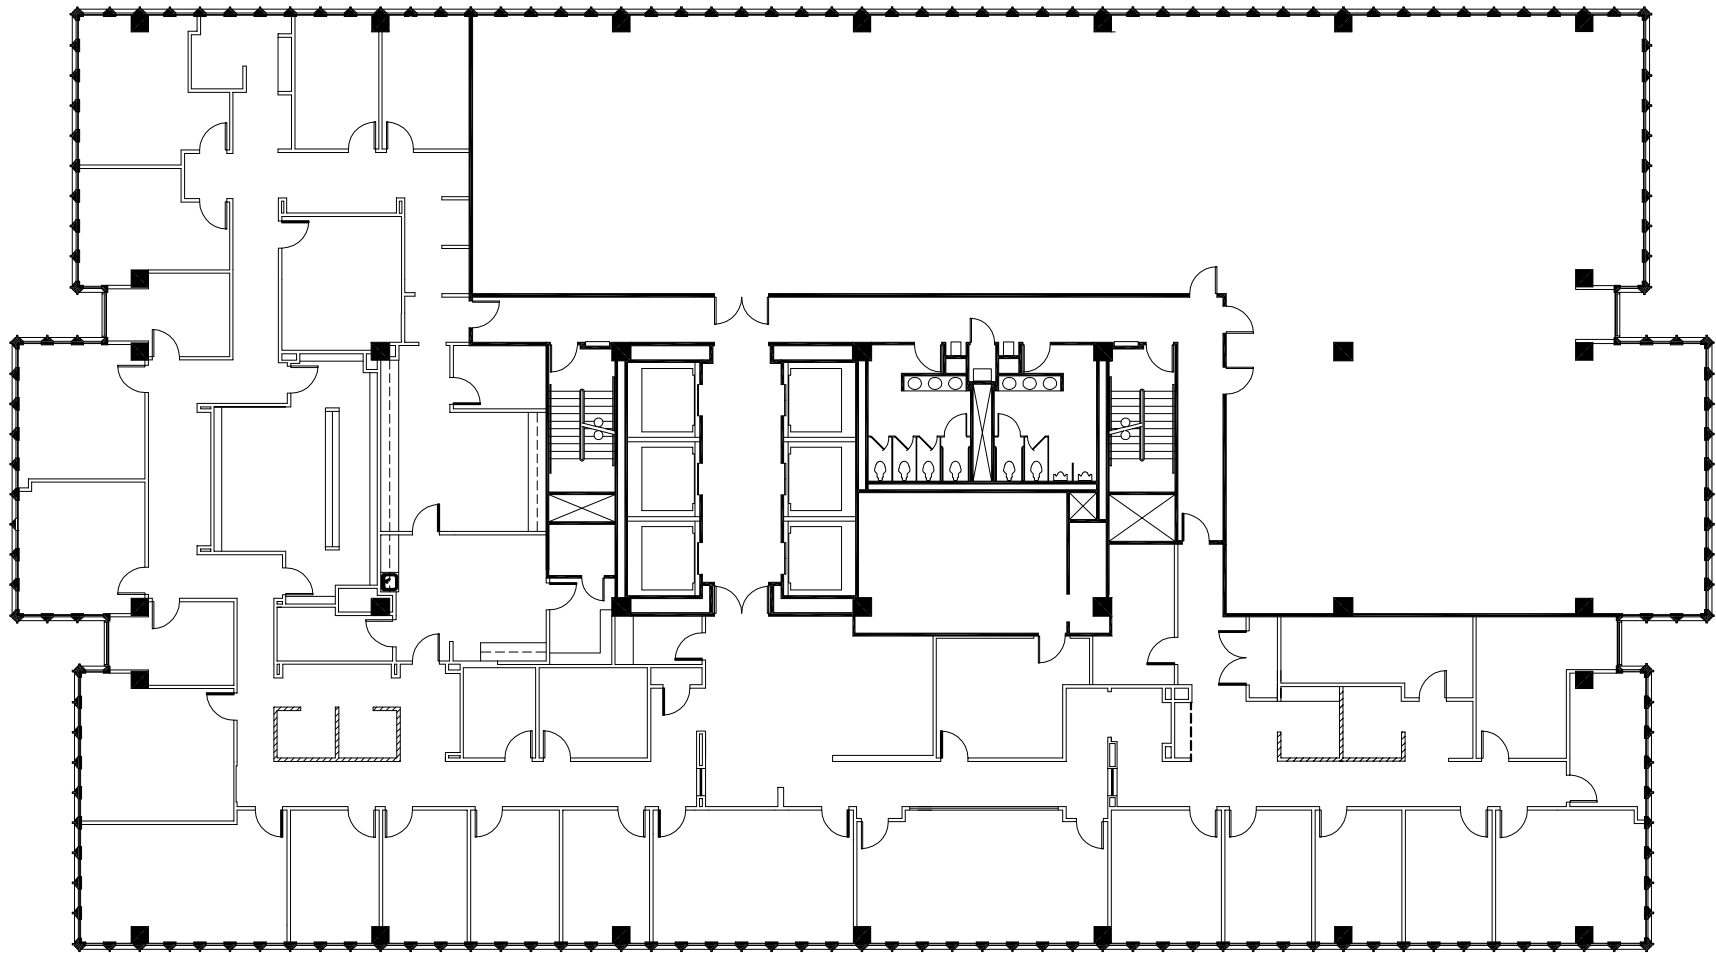


North 0 5 10 20 40



**Marquis One • 28th Floor**

**As Built**



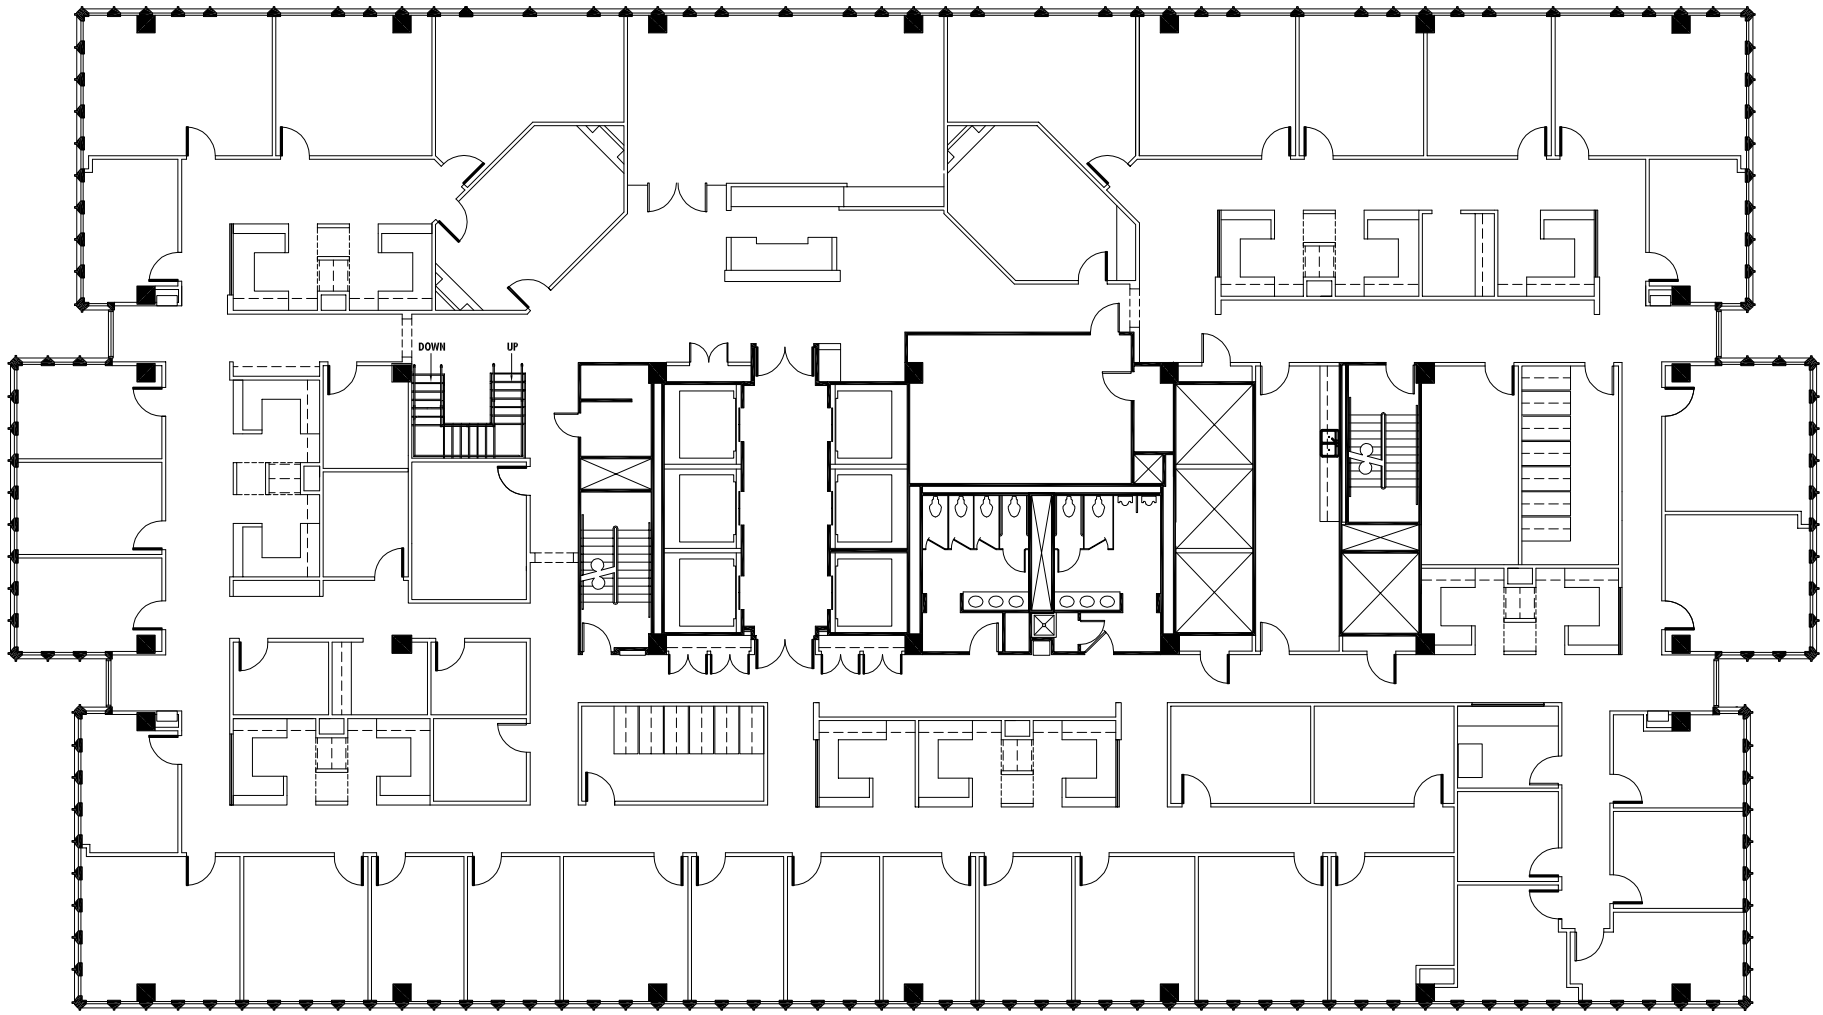


North 0 5 10 20 40

This suite has not been field  
verified by VeenendaalCave, Inc.



**Marquis Two • 15th Floor • 17,900 RSF**

**As Built**

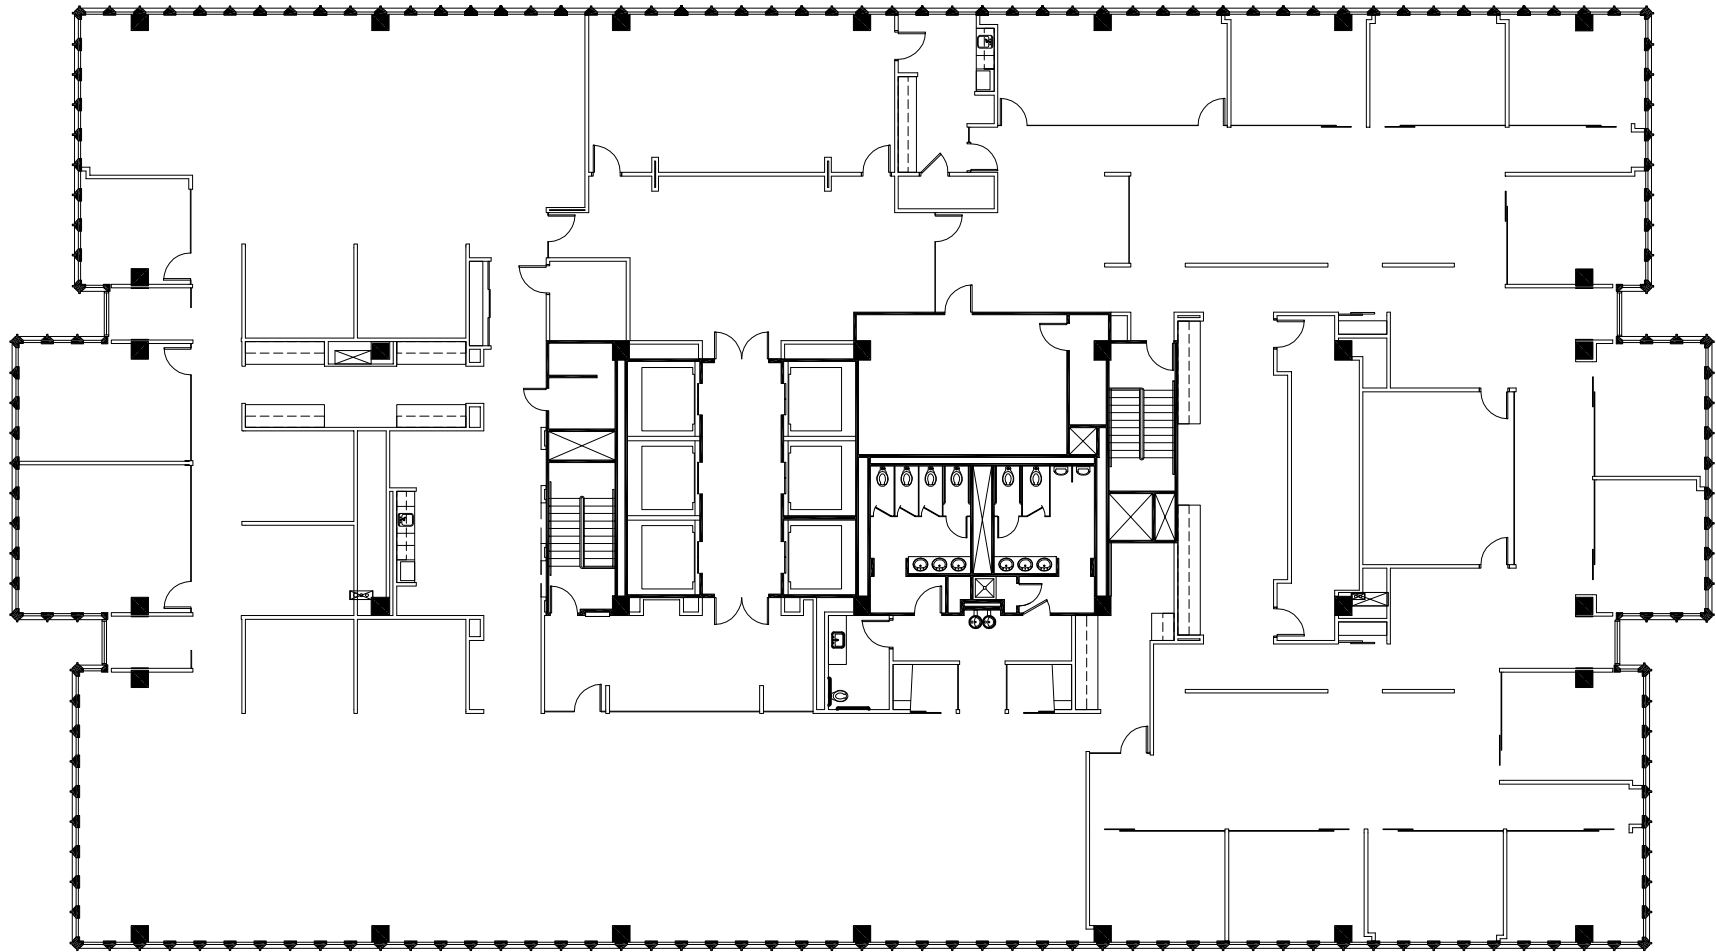

North 0 5 10 20 40



**Marquis Two • 28th floor • 18,201 RSF**

**As Built**