


Key Plan



North

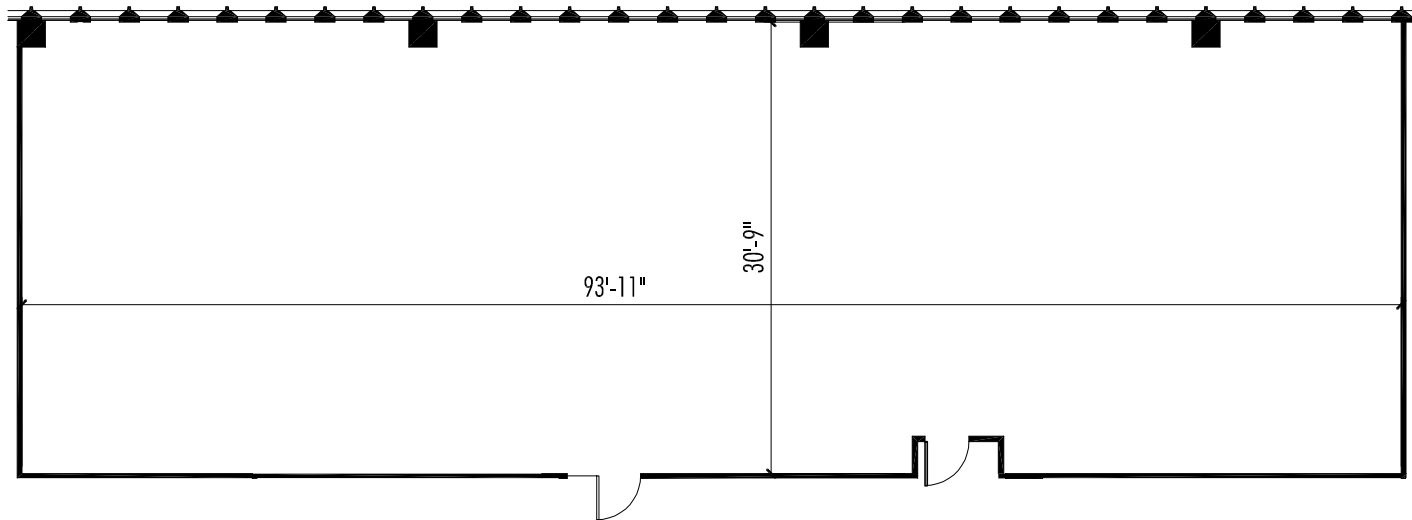

NELSON Marquis One • Suite 2550 • 15,510 RSF

As Built