


Key Plan



North

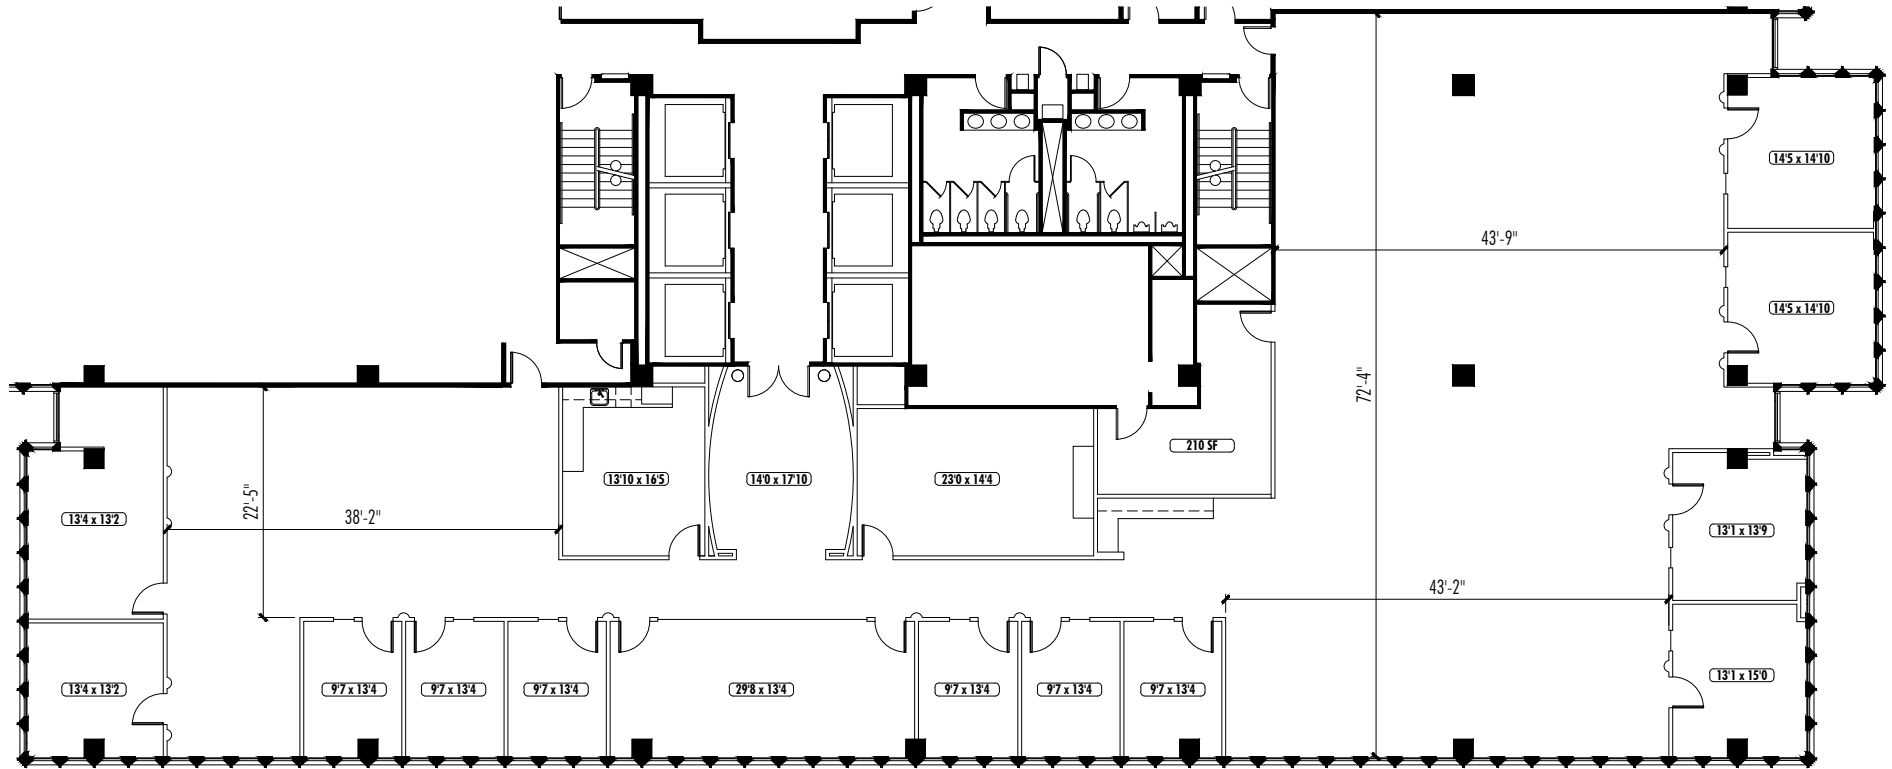

NELSON Marquis One • Suite 2000 • 10,262 RSF

As Built