

Scale: Not To Scale




North 0 5 10 20 40



Marquis One • Suite 1800 • 18,413 RSF

As Built

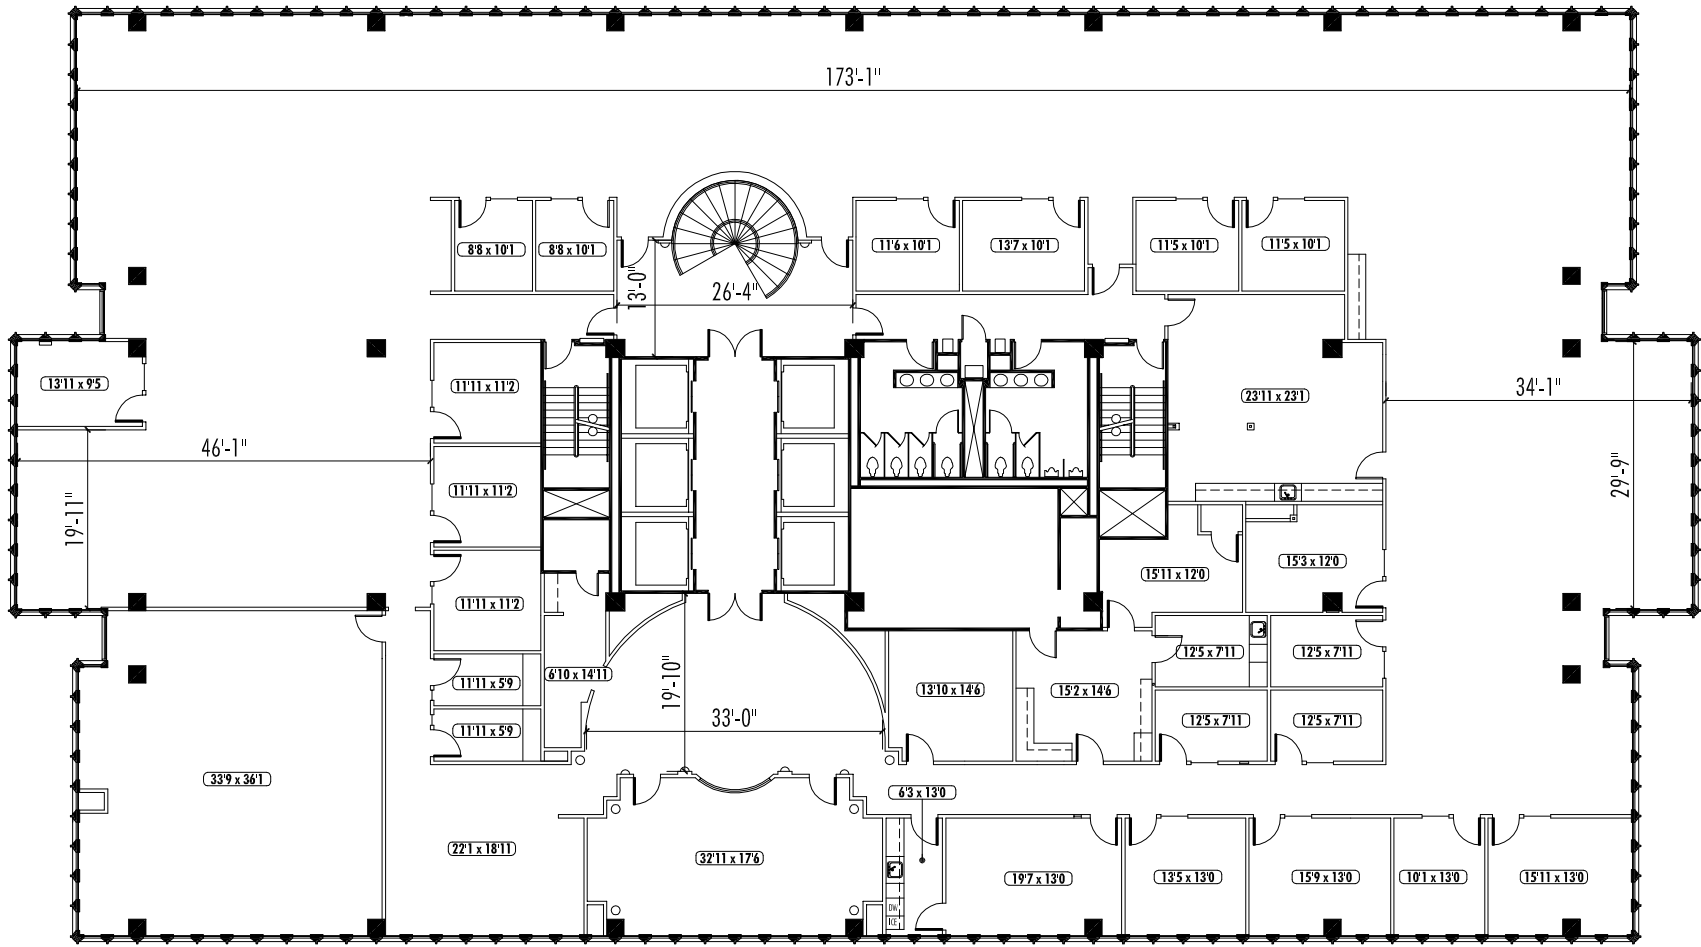

North




NELSON Marquis One • 19th Floor • 18,413 RSF

As Built



Key Plan

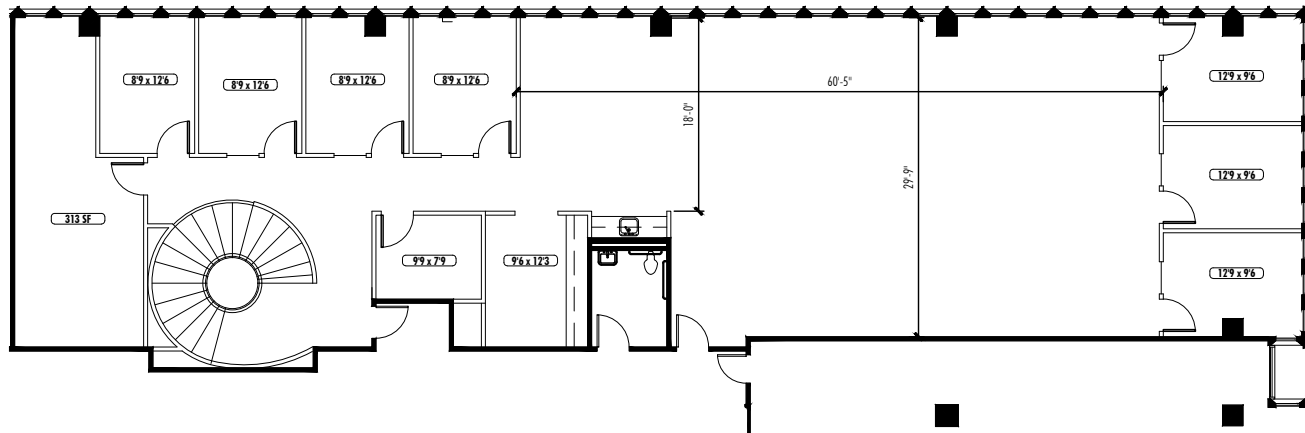

North





This suite has not been field
verified by Veenendaal Cave, Inc.



Marquis One • Suite 2001 • 4,320 RSF

As Built

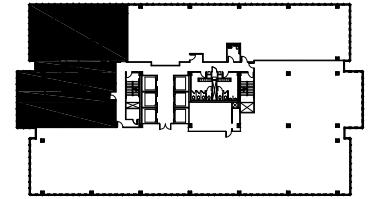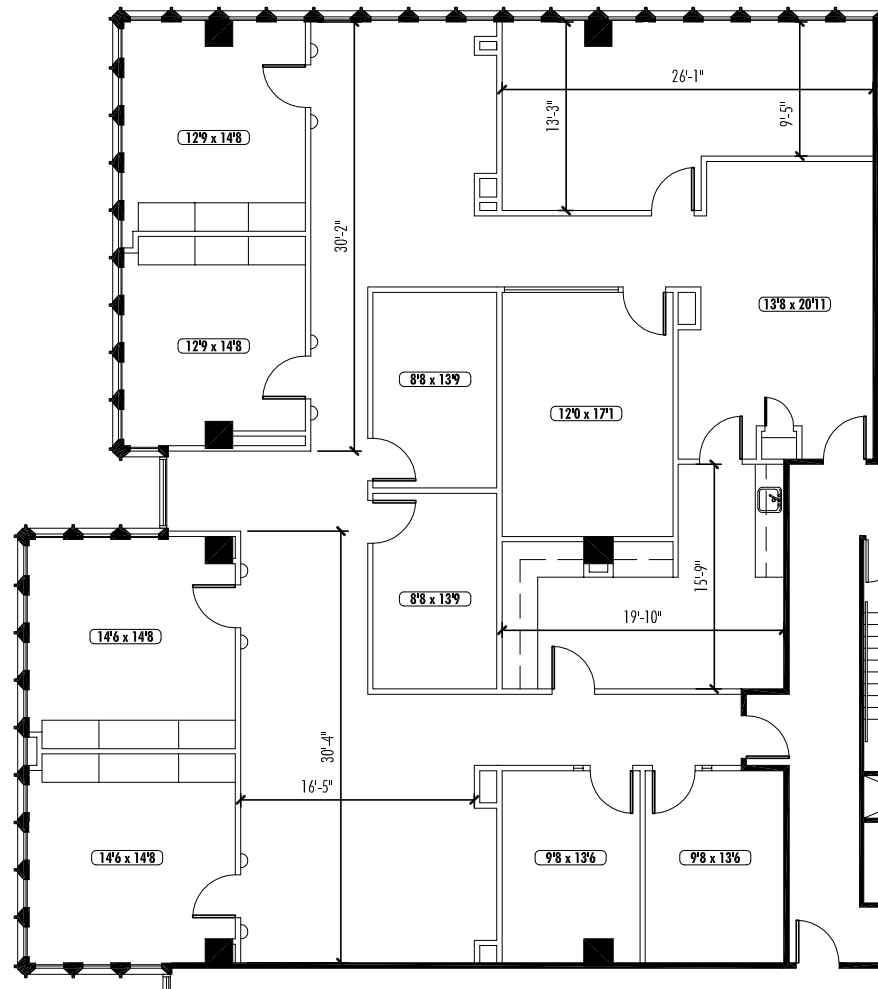

Key Plan



North



This suite has not been field
verified by Veenendaal Cave, Inc.

